
WALWORTH COUNTY SURVEYING & MAPPING LAKE GENEVA, WISCONSIN



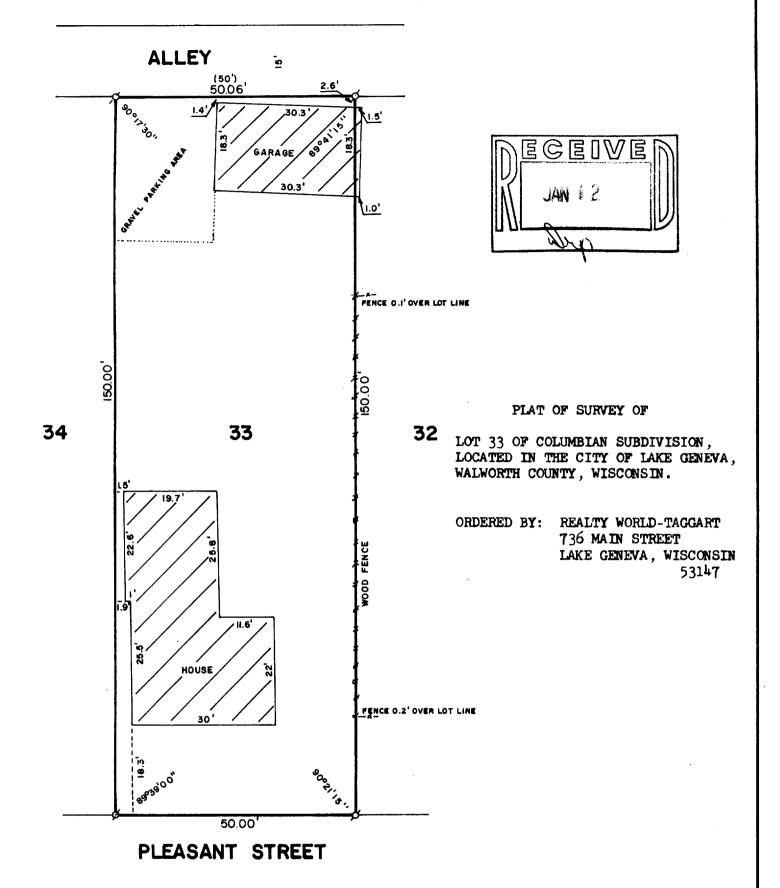

SCALE: 1"=20'

ø-IRON PIPE FOUND ()-RECORDED AS

I, ROBERT M. BAERENWALD, DO HEREBY CERTIFY THAT I HAVE SURVEYED THE PROPERTY HEREON DESCRIBED ACCORDING TO THE OFFICIAL RECORDS AND THAT THE PLAT HEREON IS A CORRECT REPRESENTATION OF THE PROPERTY LINES TO THE BEST OF MY KNOWLEDGE AND BELIEF.

Baumua ROBERT M. BAERENWALD

WISCONSIN REGISTERED LAND SURVEYOR, S-1508

DATE JOB NO. 1328

NOTE: THIS IS NOT A CERTIFIED COPY UNLESS SEALED.