
ABELL

 
SURVEYING & MAPPING DELAVAN, WISCONSIN 53115

414-728-6737

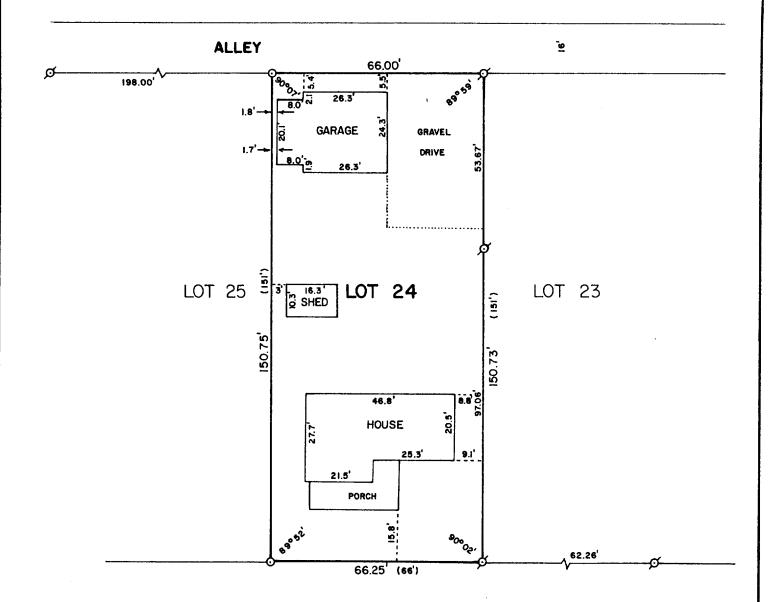

MARSHALL

STREET



PLAT OF SURVEY OF

LOT 24 OF FERGUSON'S ADDITION TO THE CITY OF LAKE GENEVA, WALWORTH COUNTY, WISCONSIN.



ORDERED BY: ANCHOR SAVINGS & LOAN

P.O. BOX 508

LAKE GENEVA, WI. 53147



SCALE - 1"=30'

LEGEND

Ø - IRON PIPE FOUND

O - IRON ROD SET

()- RECORDED AS

I, DAVID F. ABELL, DO HEREBY CERTIFY THAT I HAVE SURVEYED THE PROPERTY HEREON DESCRIBED ACCORDING TO THE OFFICIAL RECORDS AND THAT THE PLAT HEREON IS A CORRECT REPRESENTATION OF THE PROPERTY LINES TO THE BEST OF MY KNOWLEDGE AND BELIEF.

David 7. abell

DAVID F. ABELL

WISCONSIN REGISTERED LAND SURVEYOR, S-1596

DATH JOB NUMBER - 88010

NOTE: THIS IS NOT A CERTIFIED COPY UNLESS SEALED.

ZF-25