


LAKE GENEVA, WISCONSIN 53147



ø - IRON PIPE FOUND
 o - IRON
 Δ - UTILITY POLE
 ——— - OVERHEAD UTILITY
 LINE

THE EAST 2.00 FEET OF LOT 9 AND LOT 10 EXCEPT THE EAST 1.00 FOOT, BLOCK 26, OF THE ORIGINAL PLAT OF THE VILLAGE, NOW CITY OF LAKE GENEVA, WALWORTH COUNTY, WISCONSIN.

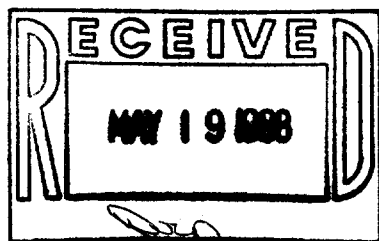

ORDERED BY: GLEN R. NELSON & MERRILL CHASE TRUST
830 MAIN STREET
LAKE GENEVA, WI. 53147

MAIN STREET

I HEREBY CERTIFY THAT I HAVE SURVEYED THE ABOVE DESCRIBED PROPERTY AND THAT THE ABOVE MAP IS A TRUE REPRESENTATION THEREOF AND SHOWS THE SIZE AND LOCATION OF THE PROPERTY, ITS EXTERIOR BOUNDARIES, THE LOCATION OF ALL VISIBLE STRUCTURES AND DIMENSIONS OF ALL PRINCIPAL BUILDINGS THEREON, BOUNDARY FENCES, APPARENT EASEMENTS, ROADWAYS AND VISIBLE ENCROACHMENTS, IF ANY, TO THE BEST OF MY KNOWLEDGE AND BELIEF.

THIS SURVEY IS MADE FOR THE USE OF THE PRESENT OWNERS OF THE PROPERTY AND ALSO THOSE WHO PURCHASE, MORTGAGE OR GUARANTEE THE TITLE THERETO WITHIN ONE (1) YEAR FROM DATE HEREOF.

SURVEY NOT VALID UNLESS SURVEYOR'S SIGNATURE IS IN RED.

HAROLD H. KOLB
WISCONSIN REGISTERED LAND SURVEYOR, S-167
DATE MAY 1983