

3

(N89°25'13"E 125.00')  
124.96

89°56'05"

90°08'05"

22.2'

23.9'

23.9'

42.4'

GRAVEL DRIVEWAY

HOUSE

29.4'

48.2'

24.2'

9.7'

42.4'

89°52'15"

125.07'  
(N89°25'13"E 125.00')

1

2

3.6'

15.1'

5.1'

5.1'

90.47'

(N0°43'57"W 90.47')


90.49'

(N0°43'57"W 90.47')

DOORWOOD DRIVE

(50')

LOT 2 OF CERTIFIED SURVEY MAP NO. 587,  
LOCATED IN SECTION 1, T 1 N, R 17 E,  
CITY OF LAKE GENEVA, WALWORTH COUNTY,  
WISCONSIN.

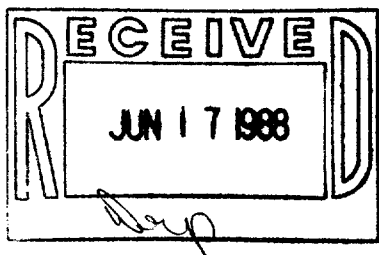

ORDERED BY: VACATION PROPERTIES NETWORK  
101 BROAD STREET  
LAKE GENEVA, WISCONSIN  
53147



Ø-IRON PIPE FOUND  
( )-RECORDED AS

I, ROBERT M. BAERENWALD, DO HEREBY CERTIFY THAT I HAVE SURVEYED THE PROPERTY HEREON DESCRIBED ACCORDING TO THE OFFICIAL RECORDS AND THAT THE PLAT HEREON IS A CORRECT REPRESENTATION OF THE PROPERTY LINES TO THE BEST OF MY KNOWLEDGE AND BELIEF.

Robert M. Baerenwald  
ROBERT M. BAERENWALD  
WISCONSIN REGISTERED LAND SURVEYOR, S-1508

DATE May 29, 1988 JOB NO. 1551

NOTE: THIS IS NOT A CERTIFIED COPY UNLESS SEALED.