
WALWORTH COUNTY SURVEYING & MAPPING LAKE GENEVA, WISCONSIN



PLAT OF SURVEY OF

LOT 3 OF MCKENNA ADDITION, LOCATED IN THE CITY OF LAKE GENEVA, WALWORTH COUNTY, WISCONSIN.

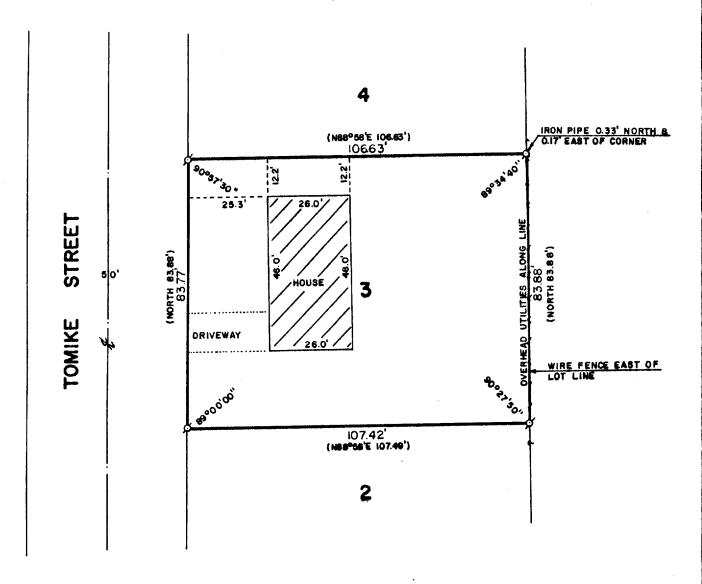

SCALE: 1"=30'

ø-IRON PIPE FOUND ()-RECORDED AS ORDERED BY: LAKESHORE REAL ESTATE 101 BROAD STREET

LAKE GENEVA, WISCONSIN 53147

IHEREBY CERTIFY THAT I HAVE SURVEYED THE ABOVE DESCRIBED PROPERTY AND THAT THE ABOVE MAP IS A TRUE REPRESENTATION THEREOF AND SHOWS THE SIZE AND LOCATION OF THE PROPERTY, ITS EXTERIOR BOUNDARIES, THE LOCATION OF ALL VISIBLE STRUCTURES AND DIMENSIONS OF ALL PRINCIPAL BUILDINGS THEREON, SQUINDARY FENCES, APPARENT EASEMENTS AND ROADWAYS AND VISIBLE ENCROACHMENTS, IF ANY.

THIS SURVEY IS MADE FOR THE EXCLUSIVE USE OF THE PRESENT OWNERS OF THE PROPERTY, AND ALSO THOSE WHO PURCHASE, MORTGAGE, OR GLARANTEE THE TITLE THERETO WITHIN ONE (I) YEAR FRUM DATE HERE OF

ROBERT M. BAERENWALD

WISCONSIN REGISTERED LAND SURVEYOR, S-1508

DATE JOB NO. 1641

NOTE: THIS IS NOT A CERTIFIED COPY UNLESS SEALED.

1-1064