

## WALWORTH COUNTY SURVEYING & MAPPING LAKE GENEVA, WISCONSIN

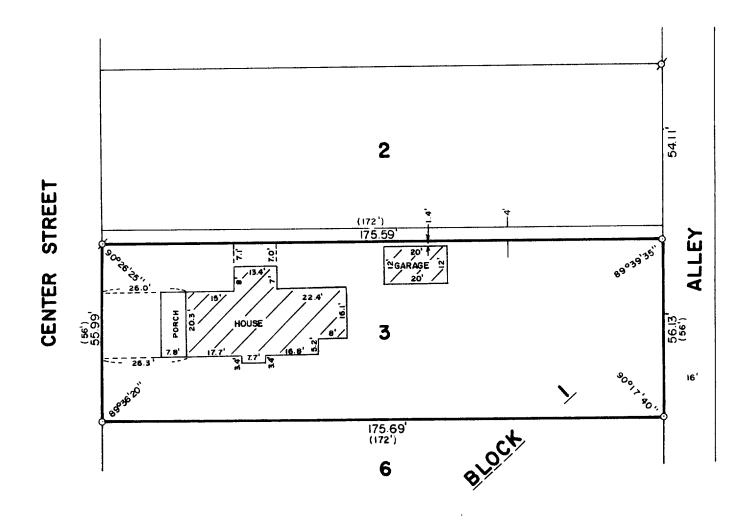

## PLAT OF SURVEY OF

LOT 3, EXCEPT THE NORTH 4 FEET THEREOF, BLOCK 1 OF THE ORIGINAL PLAT OF THE VILLAGE OF GENEVA, NOW CITY OF LAKE GENEVA, WALWORTH COUNTY, WISCONSIN.

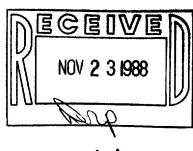

SCALE: 1"=30'

ø-IRON PIPE FOUND o -IRON ROD PLACED ()-RECORDED AS

ORDERED BY: CENTURY 21 GENEVA LAKE 503 CENTER STREET

LAKE GENEVA, WISCONSIN 53147

THEREBY CERTIFY THAT THAVE SURVEYED THE ABOVE DESCRIBED PROPERTY AND THAT THE ABOVE MAP IS A TRUE REPRESENTATION THEREOF AND BHOWS THE SIZE AND LOCATION OF THE PROPERTY, ITS EXTERIOR BOUNDARIES, THE LOCATION OF ALL VISIBLE STRUCTURES AND DIMENSIONS OF ALL PRINCIPAL BUILDINGS THEREON, BOUNDARY FENCES, APPARENT EASEMENTS AND ROADWAYS AND REPLIE ENCONCENTRATION. VISIBLE ENCROACHMENTS, IF ANY.

THIS SURVEY IS MADE FOR THE EXCLUSIVE USE OF THE PRESENT OWNERS OF THE PROPERTY, AND ALSO THOSE WHO PURCHASE, MORTDAGE, OR GUARANTEE THE TITLE THERETO WITHIN ONE (1) YEAR FROM DATE HEREOF.

ROBERT M. BAERENWALD

WISCONSIN REGISTERED LAND SURVEYOR, S-1508

JOB NO. 1708 DATE

NOTE: THIS IS NOT A CERTIFIED COPY UNLESS SEALED.