


BONNIE BRAE LANE



LOT 52 AND THE SOUTH 1/2 OF LOT 51 OF
H. E. WELLS ADDITION TO THE CITY OF
LAKE GENEVA, WALWORTH COUNTY, WISCONSIN.

RECEIVED
MAR 8 1980

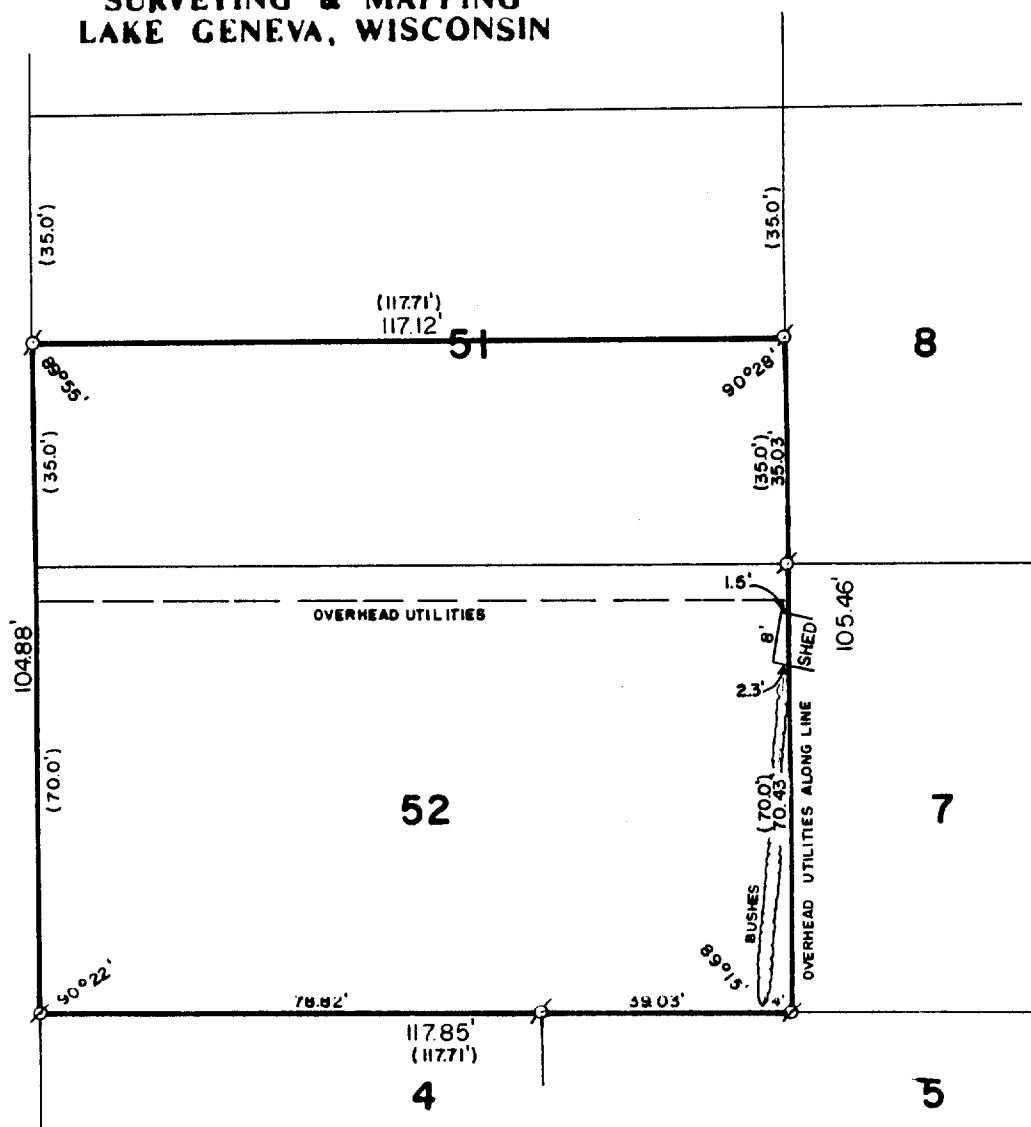

Ø - IRON PIPE FOUND
Ø - IRON ROD FOUND
() - RECORDED AS

Robert M. Baerenwald
ROBERT M. BAERENWALD
WISCONSIN REGISTERED LAND SURVEYOR, S-1508

DATE JAN. 6, 1989 JOB NO. 1435

NOTE: THIS IS NOT A CERTIFIED COPY UNLESS SEALED.

ZWE-52