


BAKER ST.

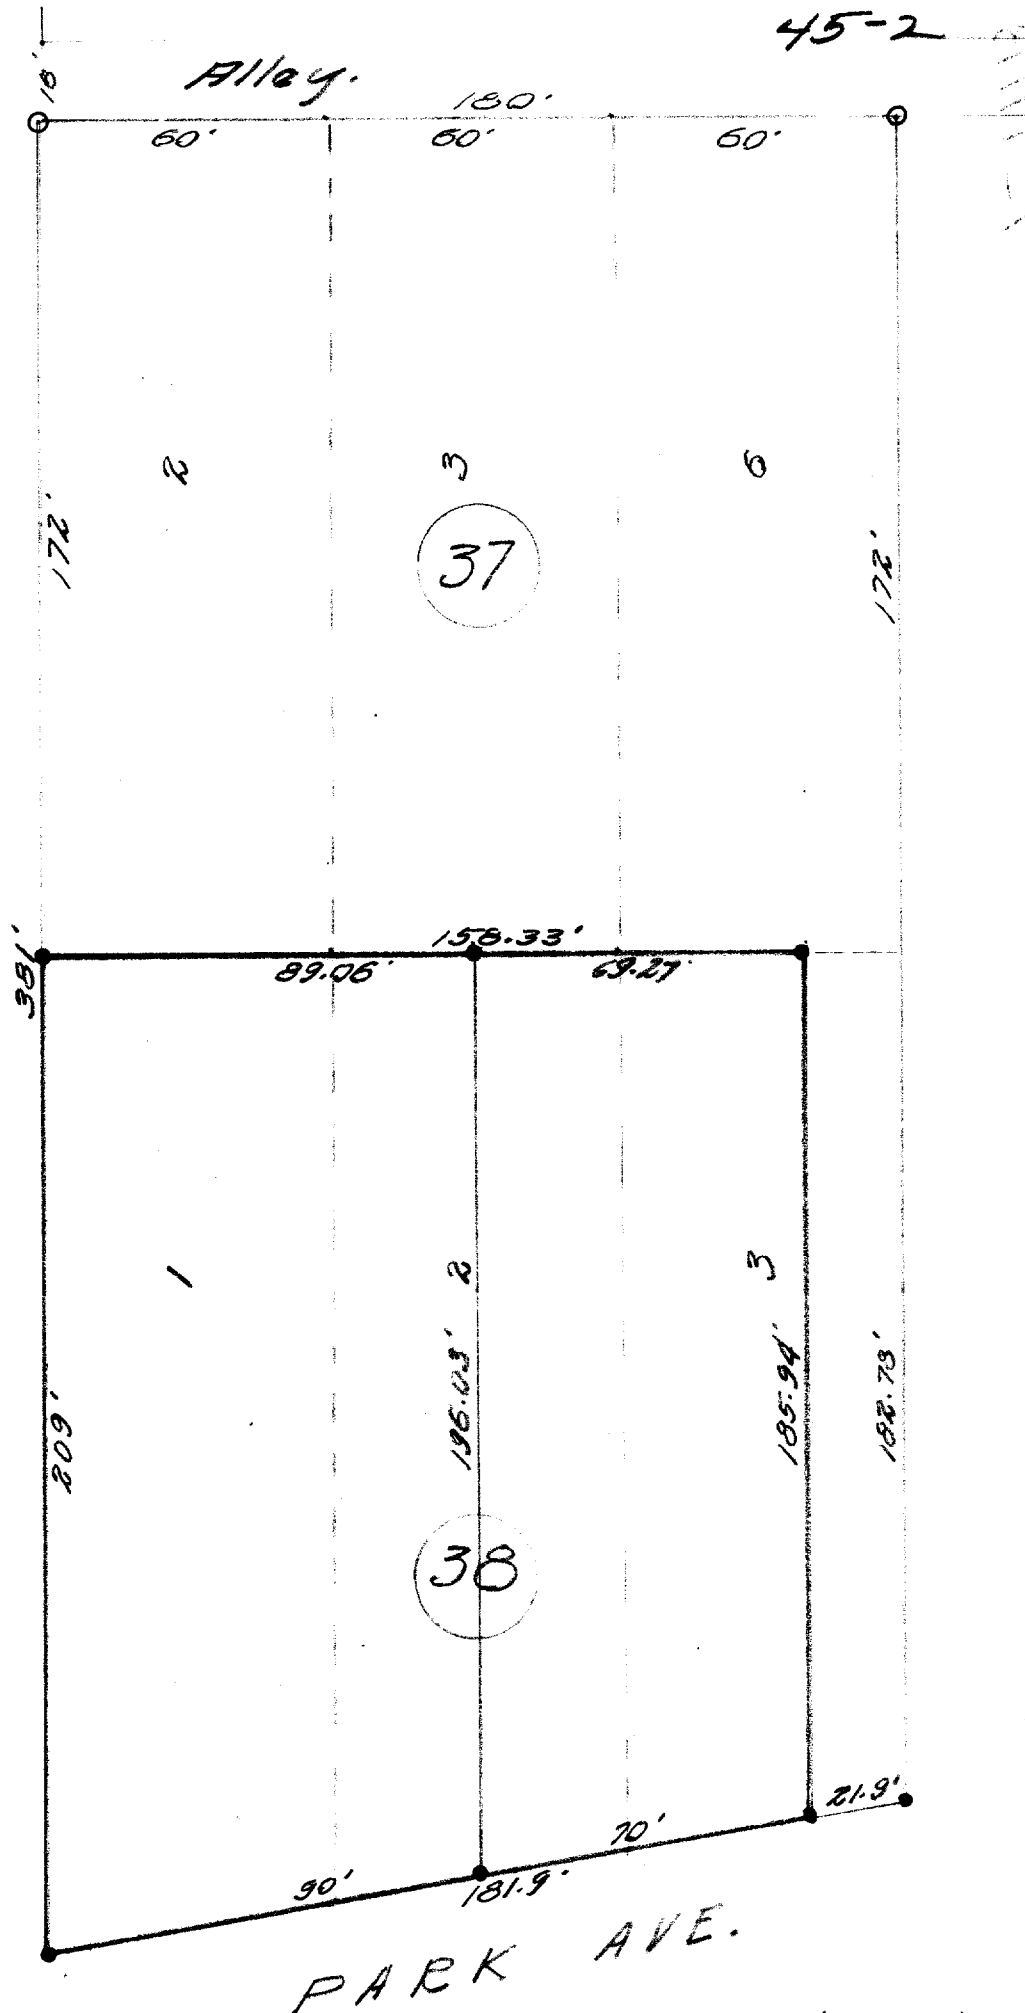

DESCRIPTION: Lots 1, 2, and a portion of Lot 3, Block 38; Original Plat of the Village (now city) of Lake Geneva, Walworth County, Wisconsin; described as follows to wit; Commencing at the N.W. corner of said Lot 1, thence S.Ely. along the Ely. line of Park Ave. 160 feet to an iron stake, thence E. 185.94 feet to an iron stake, thence N. 158.33 feet to an iron stake, thence W. 809 feet to the place of beginning.

CERTIFICATE: I, hereby certify that I have on this the 24th day of May 1945, surveyed the above described property, according to the official records, and find that no encroachments exist.
SIGNED AND SEALED THIS 25th DAY OF MAY 1945.

JOSEPH M. BIAGI Professional Engineer.
Elkhorn Wisconsin.

Joseph M. Biagi

OP-367A
367B

7-111B