

WALWORTH COUNTY SURVEYING & MAPPING LAKE GENEVA, WISCONSIN

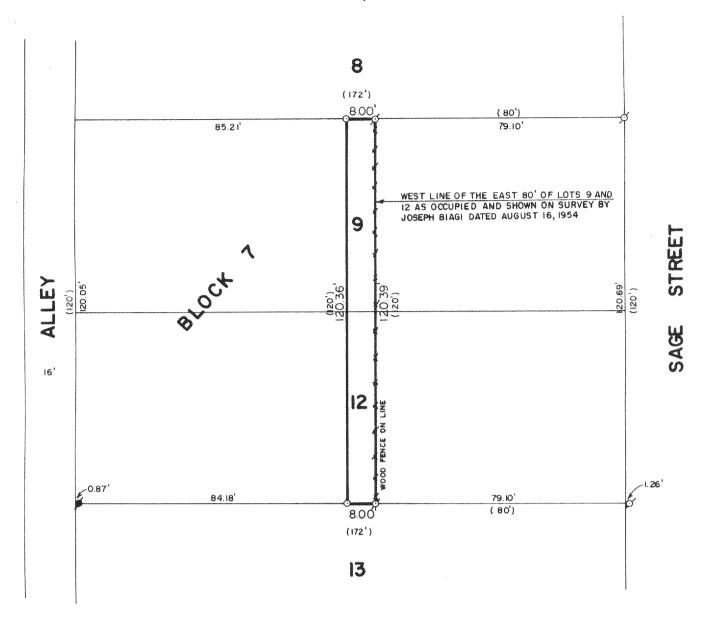

PLAT OF SURVEY OF

THE EAST 8.00 FEET OF THE WEST 92 FEET OF LOTS 9 AND 12, BLOCK 7 OF GENEVA LAKE CRAWFORD MANUFACTURING COMPANY'S SUBDIVISION, LOCATED IN THE CITY LF LAKE GENEVA, WALWORTH COUNTY, WISCONSIN.

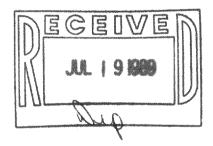

ORDERED BY: LEE THOMPSON

1114 SAGE STREET

LAKE GENEVA, WISCONSIN

53147



SCALE: 1"=30'

ø-IRON PIPE FOUND

✓ -CONCRETE MONUMENT FOUND

o - IRON PIPE PLACED

()-RECORDED AS

THEREBY CERTIFY THAT THAVE SURVEYED THE ABOVE DESCRIBED PROPERTY AND THAT THE ABOVE MAP IS A TRUE REPRESENTATION THEREOF AND SHOWS THE SIZE AND LOCATION OF THE PROPERTY, ITS EXTERIOR BOUNDARIES, THE LOCATION OF ALL VISIBLE STRUCTURES AND DIMENSIONS OF ALL PRINCIPAL BUILDINGS THEREON, BOUNDARY FENCES, APPARENT EASEMENTS AND ROADWAYS AND VISIBLE ENGROACHMENTS, IF ANY.

THIS SURVEY IS MADE FOR THE EXCLUSIVE USE OF THE PRESENT OWNERS OF THE PROPERTY, AND ALSO THOSE WHO PURCHASE, MORTGAGE, OR GUARANTEE THE TITLE THERETO WITHIN ONE (I) YEAR FROM DATE HEREOF.

HOBERT M. BAERENWALD

WISCONSIN REGISTERED LAND SURVEYOR, S-1508

DATE JUNE 1989 30B NO. 2006

NOTE: THIS IS NOT A CERTIFIED COPY UNLESS SEALED.