


MAIN 51.

45-15

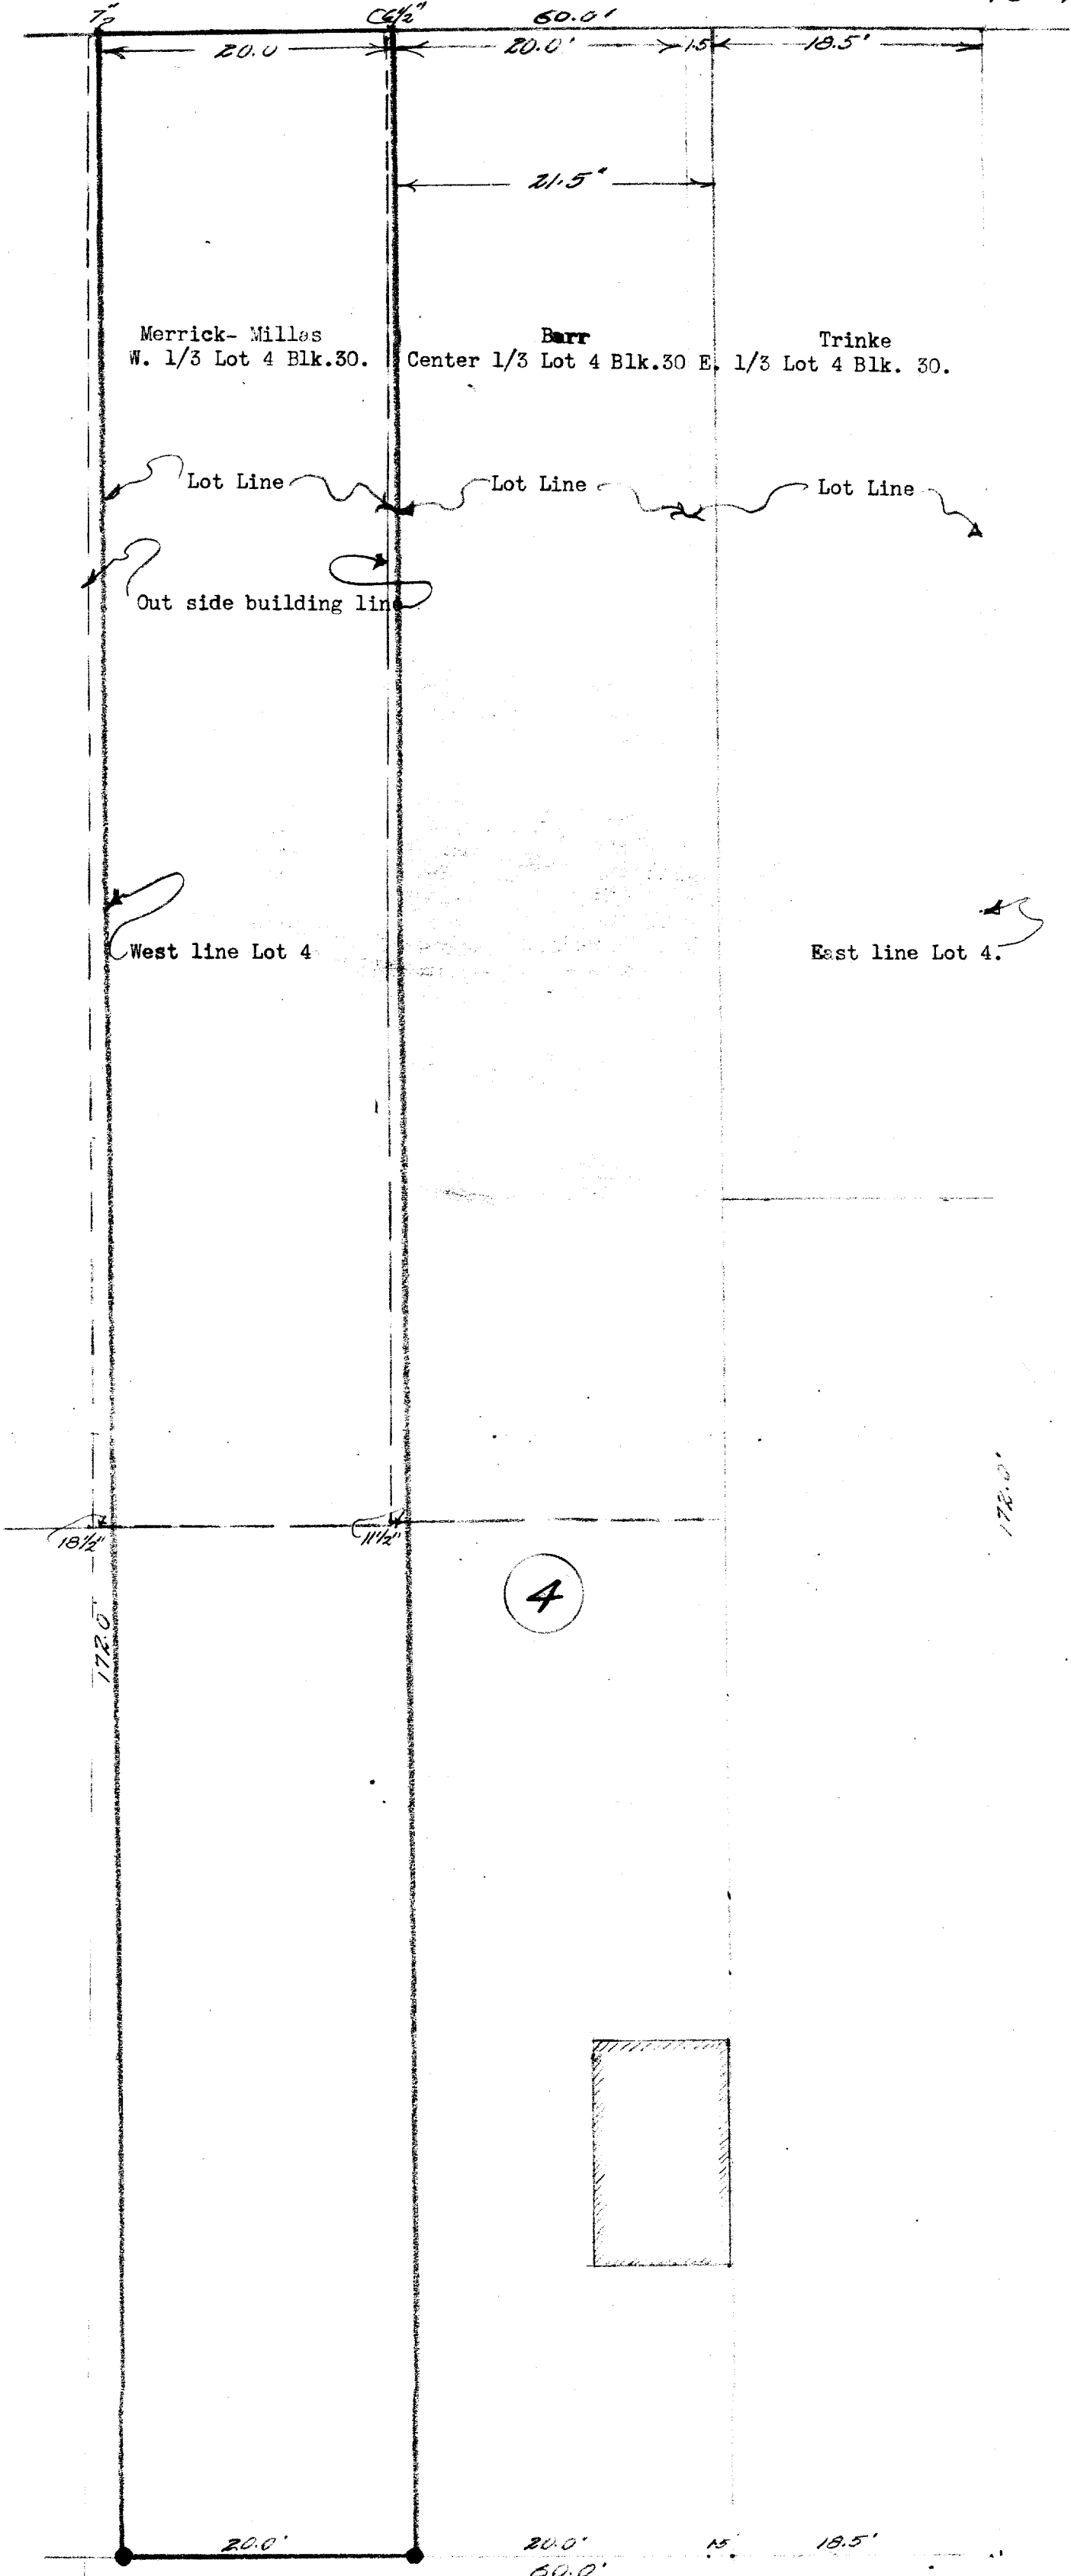

CERTIFICATE:

I, hereby certify that I have on this the 23rd day of April 1945, surveyed the above portrayed property, (the west 1/3 of Lot 4 Block 30 Original Plat of the Village of Lake Geneva) according to the official records on file in the office of the Recorder of Deeds in and for Walworth County Wisconsin, and that the above portrayal is an exact reproduction of the measurements and bearings taken at the site on this day.

SIGNED AND SEALED THIS 25th DAY OF APRIL 1945.

Joseph M. Biagi
Joseph M. Biagi C.E.
Elkhorn Wisconsin.