
# MAY 2 6 1989

# ABELL SURVEYING & MAPPING DELAVAN, WISCONSIN 53115 414-728-6787

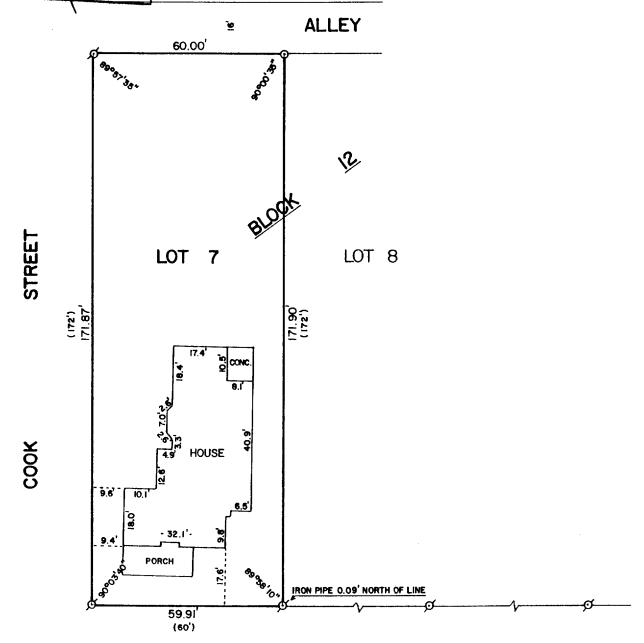

### **WISCONSIN**

### STREET

## PLAT OF SURVEY OF

LOT 7, BLOCK 12 OF THE ORIGINAL PLAT OF THE VILLAGE, NOW CITY, OF LAKE GENEVA, WALWORTH COUNTY, WISCONSIN.

ORDERED BY: ANCHOR SAVINGS & LOAN P.O. BOX 997 LAKE GENEVA, WI. 53147



SCALE - 1"=30'

DEGEND

O - IRON PIPE FOUND

O - IRON PIPE SET

( )- RECORDED AS

I HEREBY CERTIFY THAT I HAVE SURVEYED THE ABOVE DESCRIBED PROPERTY AND THAT THE ABOVE MAP IS A TRUE REPRESENTATION THEREOF AND SHOWS THE SIZE AND LOCATION OF THE PROPERTY, ITS EXTERIOR BOUNDARIES, THE LOCATION OF ALL VISIBLE STRUCTURES AND DIMENSIONS OF ALL PRINCIPAL BUILDINGS THEREON, BOUNDARY FENCES, APPARENT EASEMENTS, ROADWAYS AND VISIBLE ENCROACHMENTS, IF ANY, TO THE BEST OF MY KNOWLEDGE AND BELIEF.

THIS SURVEY IS MADE FOR THE USE OF THE PRESENT OWNERS OF THE PROPERTY, AND ALSO THOSE WHO FURCHASE, MORTGAGE, OR GUARANTEE THE TITLE THERETO WITHIN ONE (1) YEAR FROM DATE HEREOF.

David 7. abell

DAVID F. ABELL WISCONSIN REGISTERED LAND SURVEYOR, S-1596

DATE JOB NUMBER - 89005
NOTE: THIS IS NOT A CERTIFIED COPY UNLESS SEALED.

CO-905