


Hand-drawn survey map showing a property boundary along Logan Ave. The map includes bearings and distances for several segments:

- S. 35° E. 80.3'
- 140.7'
- 100'
- 65'
- 100'
- 172.65'
- 213.35'
- 203.9'
- 46.7'

A "PLACE OF BEGINNING" is marked at the bottom right. The map is oriented diagonally, with Logan Ave. running from the bottom left to the top right.

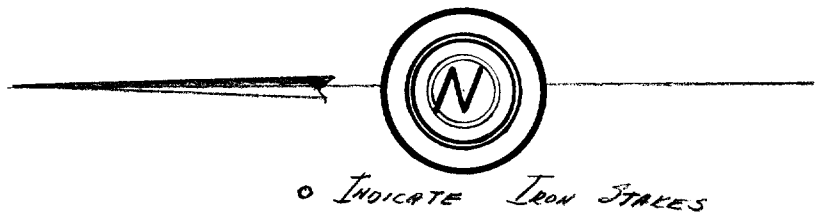

WILLOW

ST.

DESCRIPTION:

DESCRIPTION: Commencing at an iron stake that is 505.56 feet North of the South line of Section 36, Town 2 north, Range 17 east of the 4th Principal Meridian and 987.19 feet East of the East line of Willow Street of the City of Lake Geneva Walworth County, Wisconsin; thence East 213.65 feet to a point in the centerline of Logan Avenue of said city, thence N. 36° W., in the centerline of said Logan Avenue, 123.6 feet to a point, thence West 140.7 feet to an iron stake, thence South 100 feet to the place of beginning.

CERTIFICATE:

I, hereby certify that I have on this the 4th day of August 1949, surveyed the above described property according to the official record on file in the office of the Recorder of Deeds in and for Walworth County, Wisconsin, and find that the measurements and bearings of the boundary lines of said property as taken at the site on this day substantially agree with said official record and that no encroachments exist. SIGNED AND SEALED ON THIS THE 5TH DAY OF AUGUST 1949.

Joseph M. Biagi. Professional Engineer
Elkhorn Wisconsin.

OP-44, OP-411A & OP-411B