


45-20

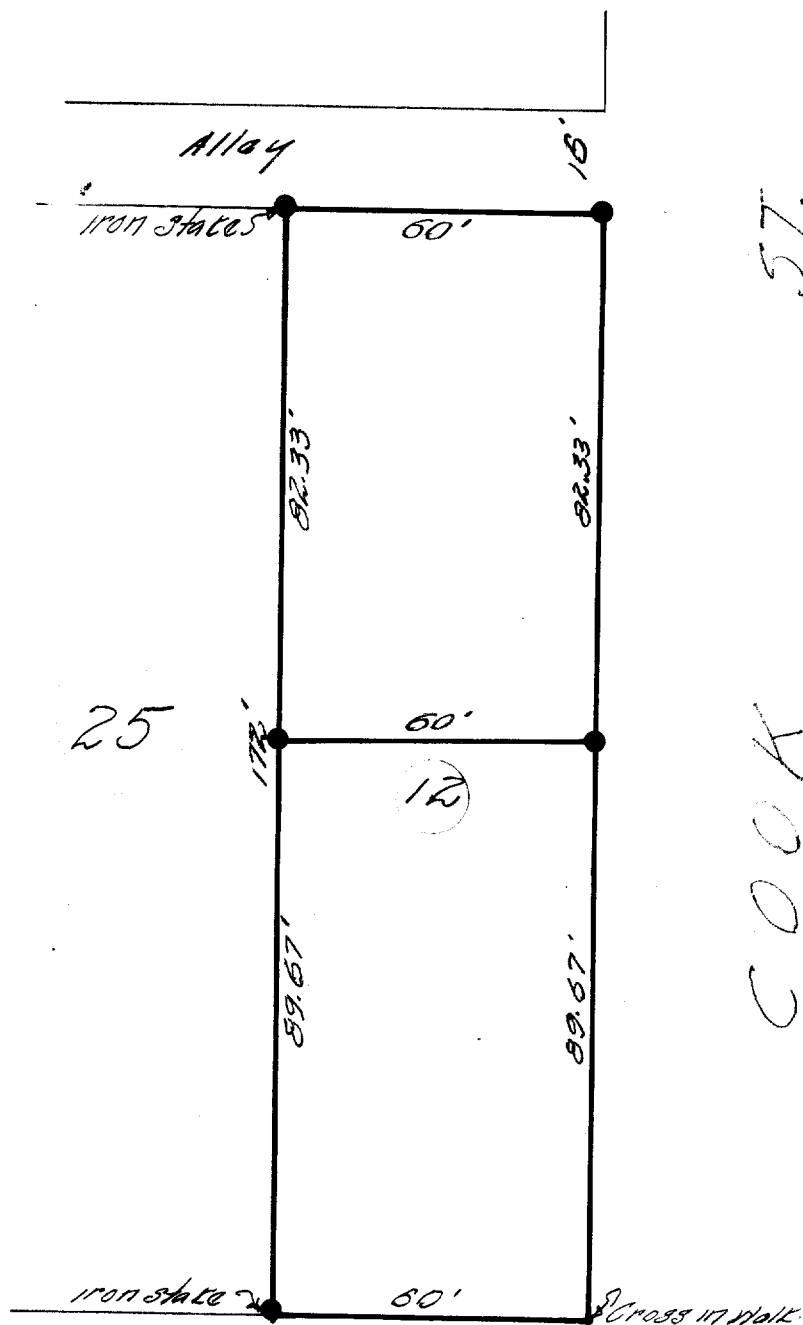

DESCRIPTION: The north 82.33 feet and the south 89.67 feet of Lot 12 Block 25, Original Plat of the Village (now city) of Lake Geneva Walworth County, Wisconsin.

CERTIFICATE: I hereby certify that I have on this the 3rd day of July 1945, surveyed the above described property according to the official records on file in the office of the Recorder of Deeds in and for Walworth County Wisconsin, and find that no encroachments exist and that the plat hereon portrayed is an exact reproduction of the conditions found at the site on this day.

SIGNED AND SEALED THIS 5th DAY OF JULY 1945.

Joseph M. Biagi
Joseph M. Biagi Professional Engineer.
Elkhorn Wisconsin.

OP-243 + OP-243A

7-115B