


45-29

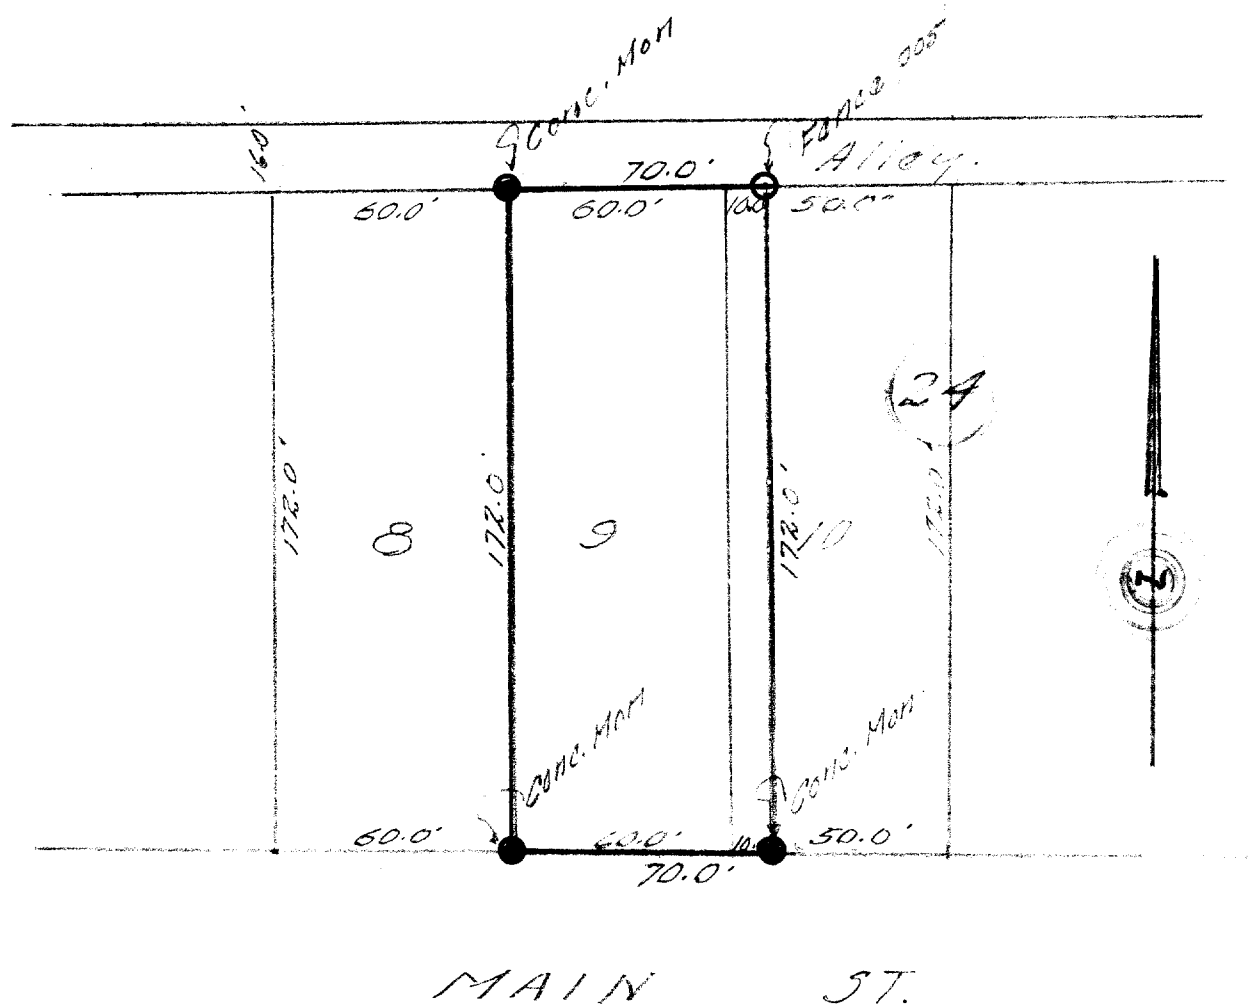

DESCRIPTION:

Lot 9 and the west ten feet of Lot 10 Block 24 Original Plat of the Village of (now City of) Lake Geneva Walworth County, Wisconsin.

CERTIFICATE:

I, hereby certify that I have on this the 21st day of January 1945, surveyed the above described property, according to the records on file in the office of the Recorder of Deeds in and for Walworth County, Wisconsin, and find that no encroachments exist, and that the plat hereon portrayed, reproduces the conditions as found at the site on this day.

SIGNED AND SEALED THIS 23rd DAY OF JANUARY 1945.

Joseph M. Biagi
Joseph M. Biagi
Professional Engineer.
Elkhorn Wisconsin.

OP-230

7-117B