
WALWORTH COUNTY SURVEYING & MAPPING LAKE GENEVA, WISCONSIN

ROGERS COURT

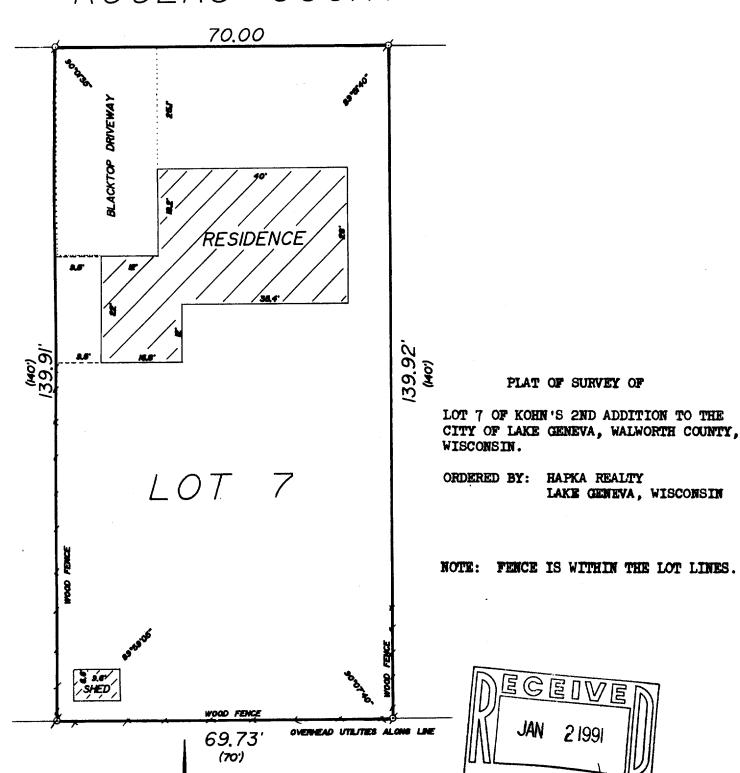

IHEREBY CERTIFY THAT I HAVE SURVEYED THE ABOVE DESCRIBED PROPERTY AND THAT THE ABOVE MAP IS A TRUE REPRESENTATION THEREOF AND BHOWS THE SIZE AND LOCATION OF THE PROPERTY. ITS EXTERIOR BOUNDARIES, THE LOCATION OF ALL VISIBLE STRUCTURES AND DIMENSIONS OF ALL PRINCIPAL BUILDINGS THEREON, BOUNDARY FENCES, APPARENT EASEMENTS AND ROADWAYS AND VISIBLE ENCROACHMENTS, IF ANY.

2 1991

THIS SURVEY IS MADE FOR THE EXCLUSIVE USE OF THE PRESENT OWNERS OF THE PROPERTY, AND ALBO THOSE WHO PUNCHASE, MORTGAGE, OR GUARANTEE THE TITLE THERETO WITHIN ONE (I) YEAR FROM DATE HEREOF.

ø -IRON PIPE FOUND

SCALE: 1"=20"

ø-IRON BAR IN CONCRETE FOUND

()-RECORDED AS

ROBERT M. BAERENWALD

WISCONSIN REGISTERED LAND SURVEYOR, S-1508

JOB NO. 2136

NOTE: THIS IS NOT A CERTIFIED COPY UNLESS SEALED.

Survey# 007-1191

TAX KEY#ZK2, DODDS