
WALWORTH COUNTY SURVEYING & MAPPING LAKE GENEVA, WISCONSIN

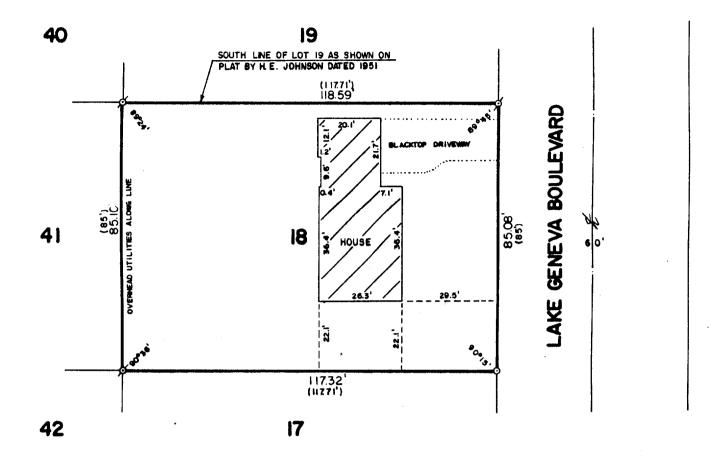

PLAT OF SURVEY OF


LOT 18 OF M. E. WELLS ADDITION TO THE CITY OF LAKE GENEVA, WALWORTH COUNTY, WISCONSIN.

ORDERED BY: COLDWELL BANKER

GENEVA LAKES AREA REALITORS

838 MAIN STREET

IAKE GENEVA, WISCONSIN 53147

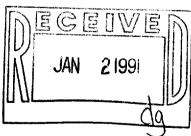

I HEREBY CERTIFY THAT I HAVE SURVEYED THE ABOVE DESCRIBED PROPERTY AND THAT THE ABOVE MAP IS A TRUE REPRESENTATION THEREOF AND SHOWS THE SIZE AND LOCATION OF THE PROPERTY, ITS EXTERIOR BOUNDARIES, THE LOCATION OF ALL VISIBLE STRUCTURES AND DIMENSIONS OF ALL PRINCIPAL BUILDINGS THEREON, BOUNDARY FENCES, APPARENT EASEMENTS AND ROADWAYS AND VISIBLE ENCROACHMENTS, IF ANY.

THIS SURVEY IS MADE FOR THE EXCLUSIVE USE OF THE PRESENT OWNERS OF THE PROPERTY, AND ALSO THOSE WHO PURCHASE, MORTGAGE, OR GUARANTEE THE TITLE THERETO WITHIN ONE (I) YEAR FROM DATE HEREOF.

SCALE: 1"=30'

ø-Iron Pipe Found

o - IRON PIPE PLACED

()-RECORDED AS

Mont M. BULLINGE ROBERT M. BAERENWALD

WISCONSIN REGISTERED LAND SURVEYOR, 5-1508

DATE JOB NO. 2065

NOTE: THIS IS NOT A CERTIFIED COPY UNLESS SEALED.

Survey# 007-1208

TAX KEY# ZWE DOOD B