

WALWORTH COUNTY SURVEYING & MAPPING LAKE GENEVA, WISCONSIN

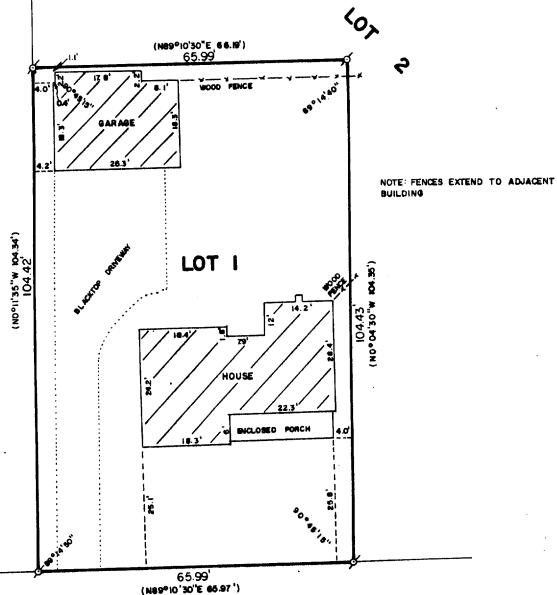

HENRY STREET

PLAT OF SURVEY OF

LOT 1 OF CERTIFIED SURVEY MAP NO. 855. LOCATED IN THE CITY OF LAKE GENEVA, WALWORTH COUNTY, WISCONSIN.

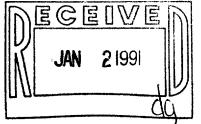

ORDERED BY: CHRISTOPHER WICYK 909 HENRY STREET LAKE GENEVA, WISCONSIN 53147



SCALE: 1"=30'

ø-IRON PIPE FOUND ()-RECORDED AS

THEREBY CERTIFY THAT I HAVE SURVEYED THE ABOVE DESCRIBED PROPERTY AND THAT THE ABOVE MAP IS A TRUE REPRESENTATION THEREOF AND BROWN THE SIZE AND LOCATION OF THE PIR BERTHY. ITS EXTERNOR BOUNDARIES, THE LOCATION OF ALL VISIBLE STRUCTURES AND DIMENSIONS OF ALL PRINCIPAL BUILDINGS THEREON, BOUNDARY FENCES, APPARENT EASEMENTS AND ROADWAYS AND VISIBLE ENCROACHMENTS, IF ANY.

THIS SURVEY IS MADE FOR THE EXCLUSIVE USE OF THE PRESENT OWNERS OF THE PROPERTY, AND ALBO THOSE WHO PURCHASE, MORTGAGE, OR GUARANTEE THE TITLE THERETO WITHIN ONE (1) YEAR FROM DATE HEREOF.

WISCONSIN REGISTERED LAND SURVEYOR, S-1508

1989 DATE JOB NO. 2059

NOTE: THIS IS NOT A CERTIFIED COPY UNLESS SEALED.

Survey # pp 7 - 1209

TAX KEY#ZA855\$POPDI