


WALWORTH COUNTY  
SURVEYING & MAPPING  
LAKE GENEVA, WISCONSIN  
414-248-0505

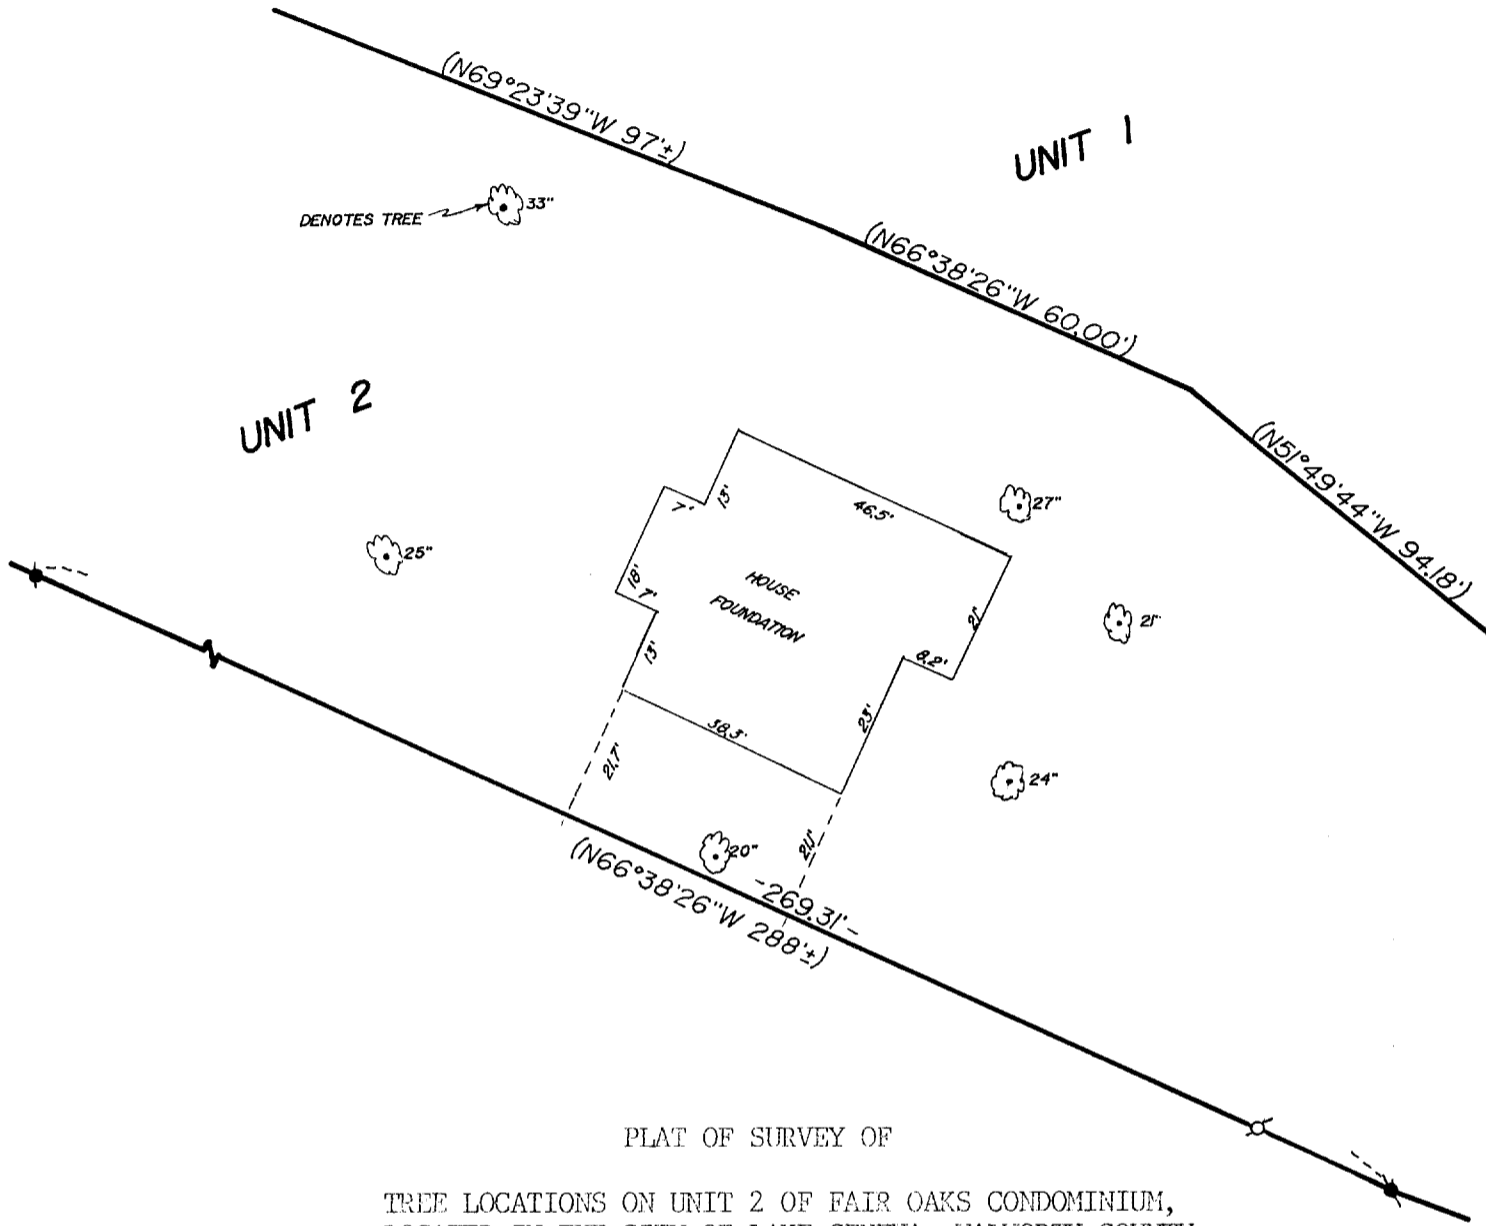


PLAT OF SURVEY OF


TREE LOCATIONS ON UNIT 2 OF FAIR OAKS CONDOMINIUM,  
LOCATED IN THE CITY OF LAKE GENEVA, WALWORTH COUNTY,  
WISCONSIN.

ORDERED BY: JAWORT LOUELL  
150 NORTH WALWORTH  
WILLIAMS BAY, WISCONSIN

REVISED: DEC. 5, 1989 TO SHOW FOUNDATION  
LOCATION.

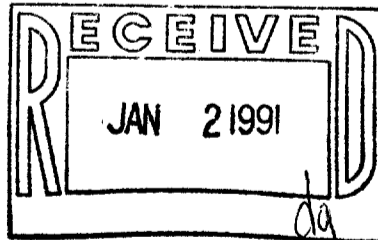

I HEREBY CERTIFY THAT THE TREE LOCATIONS SHOWN  
HEREON ARE ACCURATE TO THE BEST OF MY KNOWLEDGE  
AND BELIEF.

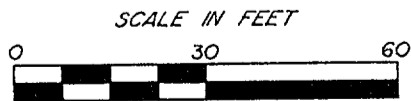

- ⊘ - IRON PIPE FOUND
- - STONE MONUMENT FOUND
- ( ) - RECORDED AS

*Robert M. Baerenwald*  
ROBERT M. BAERENWALD  
WISCONSIN REGISTERED LAND SURVEYOR S-1508  
Oct. 22, 1989  
DATE JOB NO. 2209  
NOTE: THIS IS NOT A CERTIFIED COPY UNLESS SEALED.

Survey # 007-1215

TAX KEY # ZFA 00002