

WALWORTH COUNTY  
SURVEYING & MAPPING  
LAKE GENEVA, WISCONSIN


MAIN STREET

STUMP AT CORNER (N78°30'E 91.8')  
91.02' PLACE OF BEGINNING

PLAT OF SURVEY OF

PART OF THE NE 1/4 OF SECTION 35, T 2 N, R 17 E,  
CITY OF LAKE GENEVA, COUNTY OF WALWORTH, STATE OF  
WISCONSIN; DESCRIBED AS FOLLOWS: COMMENCING AT  
A POINT IN THE SOUTHERLY LINE OF MAIN STREET THAT  
IS 152.15 FEET S78°30'W OF THE POINT OF INTERSECTION  
OF SAID SOUTH LINE OF MAIN STREET WITH THE EAST  
LINE OF SECTION 35; THENCE S12°27'E 425.6 FEET TO  
A POINT IN THE SHORE OF GENEVA LAKE; THENCE  
S67°59'W ALONG THE SHORE OF SAID LAKE GENEVA 71  
FEET TO A POINT; THENCE N15°22'W 436.05 FEET TO AN  
IRON STAKE; THENCE N78°30'E 91.8 FEET TO THE PLACE  
OF BEGINNING.

ORDERED BY: VACATION PROPERTIES NETWORK  
101 BROAD STREET  
LAKE GENEVA, WISCONSIN  
53147

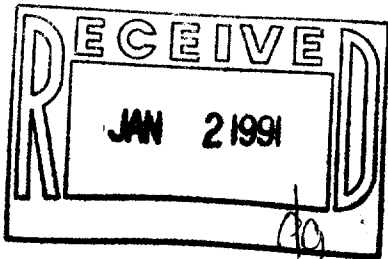

SCALE: 1"=40'

σ - IRON PIPE FOUND  
( ) - RECORDED AS


I HEREBY CERTIFY THAT I HAVE SURVEYED THE ABOVE DESCRIBED PROPERTY AND THAT THE ABOVE  
MAP IS A TRUE REPRESENTATION THEREOF AND SHOWS THE SIZE AND LOCATION OF THE PROPERTY,  
ITS EXTERIOR BOUNDARIES, THE LOCATION OF ALL VISIBLE STRUCTURES AND DIMENSIONS OF ALL  
PRINCIPAL BUILDINGS THEREON, BOUNDARY FENCES, APPARENT EASEMENTS AND ROADWAYS AND  
VISIBLE ENCROACHMENTS, IF ANY.

THIS SURVEY IS MADE FOR THE EXCLUSIVE USE OF THE PRESENT OWNERS OF THE PROPERTY, AND  
ALSO THOSE WHO PURCHASE, MORTGAGE, OR GUARANTEE THE TITLE THERETO WITHIN ONE (1) YEAR  
FROM DATE HEREOF.

*Robert M. Baerenwald*  
ROBERT M. BAERENWALD  
WISCONSIN REGISTERED LAND SURVEYOR, S-1508

DATE *Jan. 19, 1989* JOB NO. 1827

NOTE: THIS IS NOT A CERTIFIED COPY UNLESS SEALED.

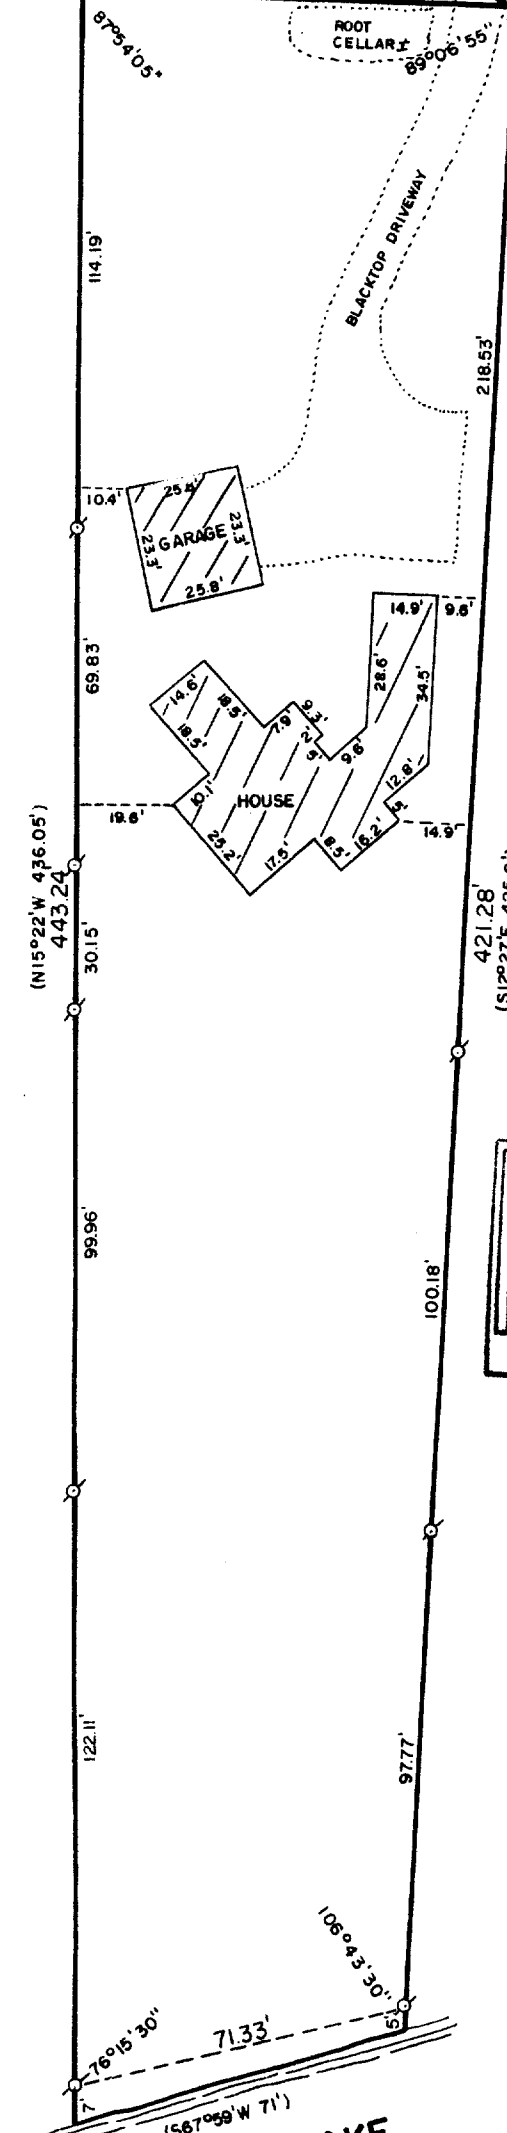

GENEVA LAKE