

**SURVEYING & SUBDIVIDING
DELAN, WISCONSIN 53115**

N

corner of building 0.09' South
and 2.47' West of Property corner S T R E E T (60')

✕ = 1" Iron Pipe Found bent and
 reset 1" X 24" Iron Pipe
 ✕ = 3/4" Iron Pipe Found
 ✕ = 1/2" X 24" Iron Pipe Set
 ○ = 3/4" X 24" Iron Pipe Set
 ● = 1 1/4" X 24" Iron Pipe Set
 ✕ = 1 1/4" Iron Pipe Found


Bearings referenced to the previously assumed bearing of East along the south line of North Street.

I, George T. Dunham, Surveyor, certify that I have surveyed the property described as follows:

and that the plat shown hereon is a correct representation thereof and shows the size and location of the property, its exterior boundaries the location of all visible structures and dimensions of all principal buildings thereon, boundary fences, apparent easements, roadways and visible encroachments, if any, and that I have surveyed the property hereon described, according to the official records, to the best of my knowledge and belief.

March 17, 1990

George T. Dunham
George T. Dunham, Surveyor

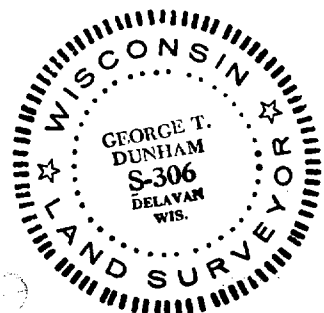

APR 21 1960

mg

007-1273

ZOP 00028