




# Plat of Survey

of

Lot 2 of Certified Survey Map #2020 located in the City of Lake Geneva  
Walworth County, Wisconsin

Surveyed for: Ed Wellnitz Builders  
1001 Highway 14 North  
Janesville, WI 53545

Bearings referenced to C.S.M.2020

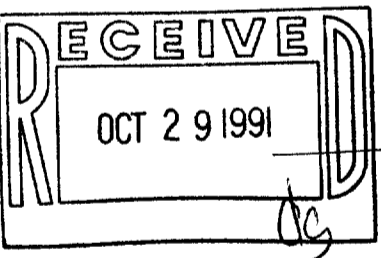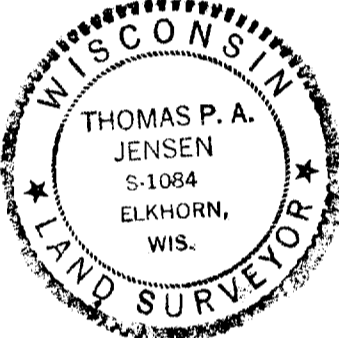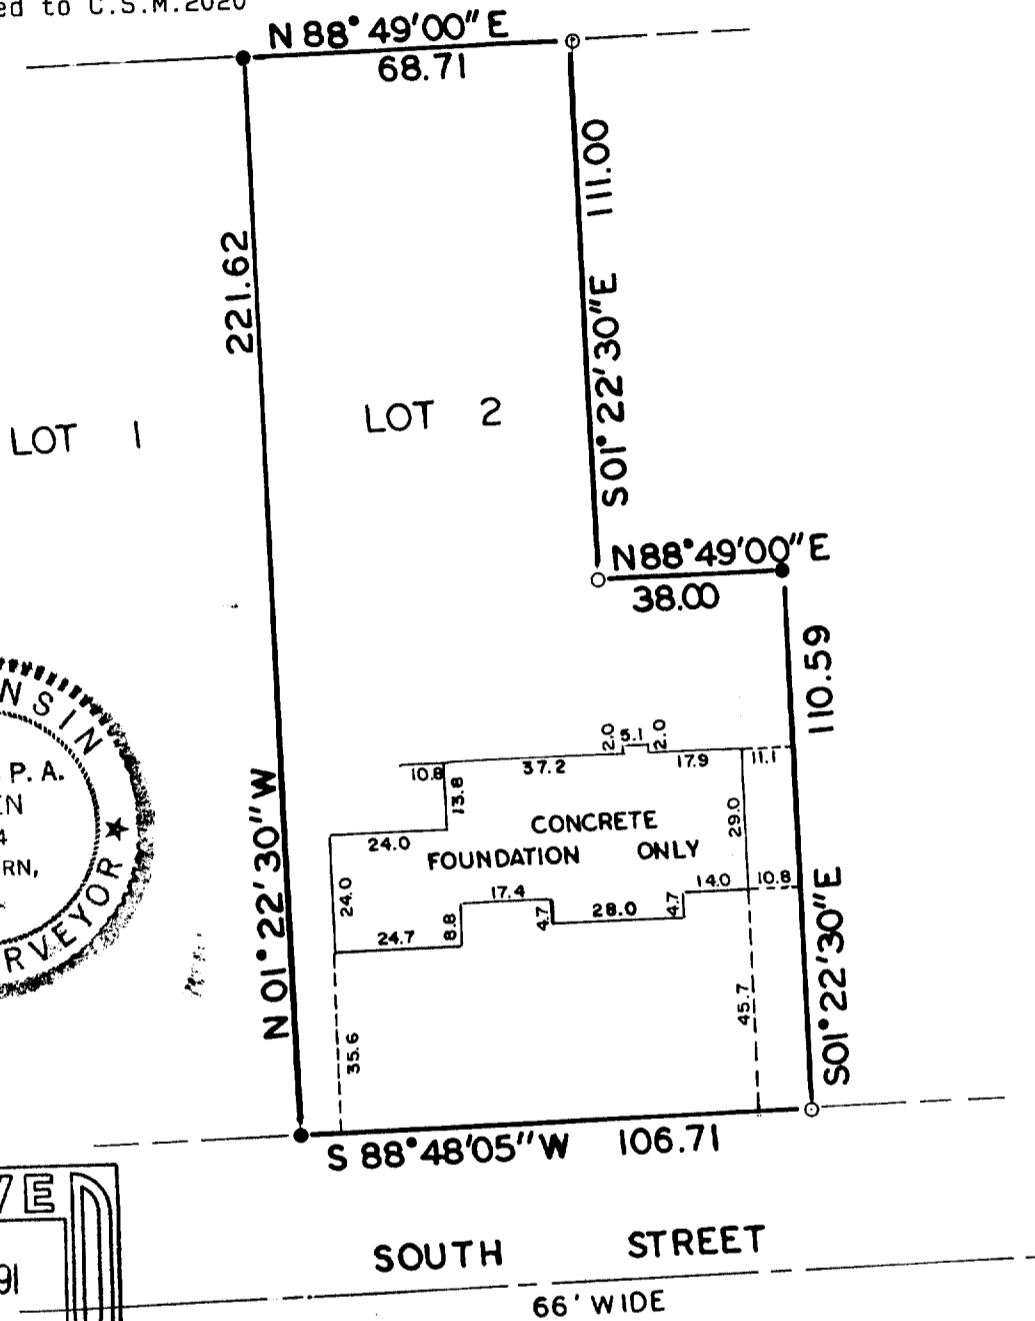

Copyright © 1991 by Jensen Surveying & Mapping S.C.  
All rights reserved. No part of this survey plat may be reproduced or transmitted in any form by any means - graphic, electronic, or mechanical, including photocopying, tracing, or information storage and retrieval systems - without permission in writing from Thomas P.A. Jensen.

I, Thomas P.A. Jensen, Wisconsin Registered Land Surveyor, do hereby certify that this survey was performed by me, or under my direction, in full compliance with the owner's/agent's instructions and Chapter A-E 7 of the Wisconsin Administrative Code 'Minimum Standards For Property Surveys', and that this map is an accurate representation thereof to the best of my knowledge and belief.

Note: This survey plat is not certified unless signed and sealed in red ink.

*Thomas P.A. Jensen*  
Thomas P.A. Jensen R.L.S. 1084

**Jensen Surveying & Mapping S.C.**

45 South Wisconsin Street P.O. Box 322  
Elkhorn, Wisconsin. 53121.  
(414) 723-3434

Mapping date: 9/26/91,


Revisions: \_\_\_\_\_

Legend

- ~ Found iron pipe
- ~ Found iron rod

Sheet 1 of 1 Sheets

Scale: 1 = 40'

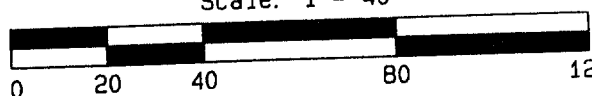

Job reference number:

1202A20200002 1991.166A

007-1275