



# Plat of Survey

of

Lot 2 of Certified Survey Map #2020 located in the City of Lake Geneva  
Walworth County, Wisconsin

Surveyed for: Ed Wellnitz Builders  
1001 Highway 14 North  
Janesville, WI 53545

Bearings referenced to C.S.M.2020

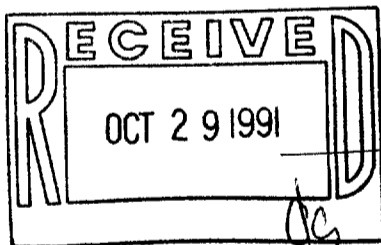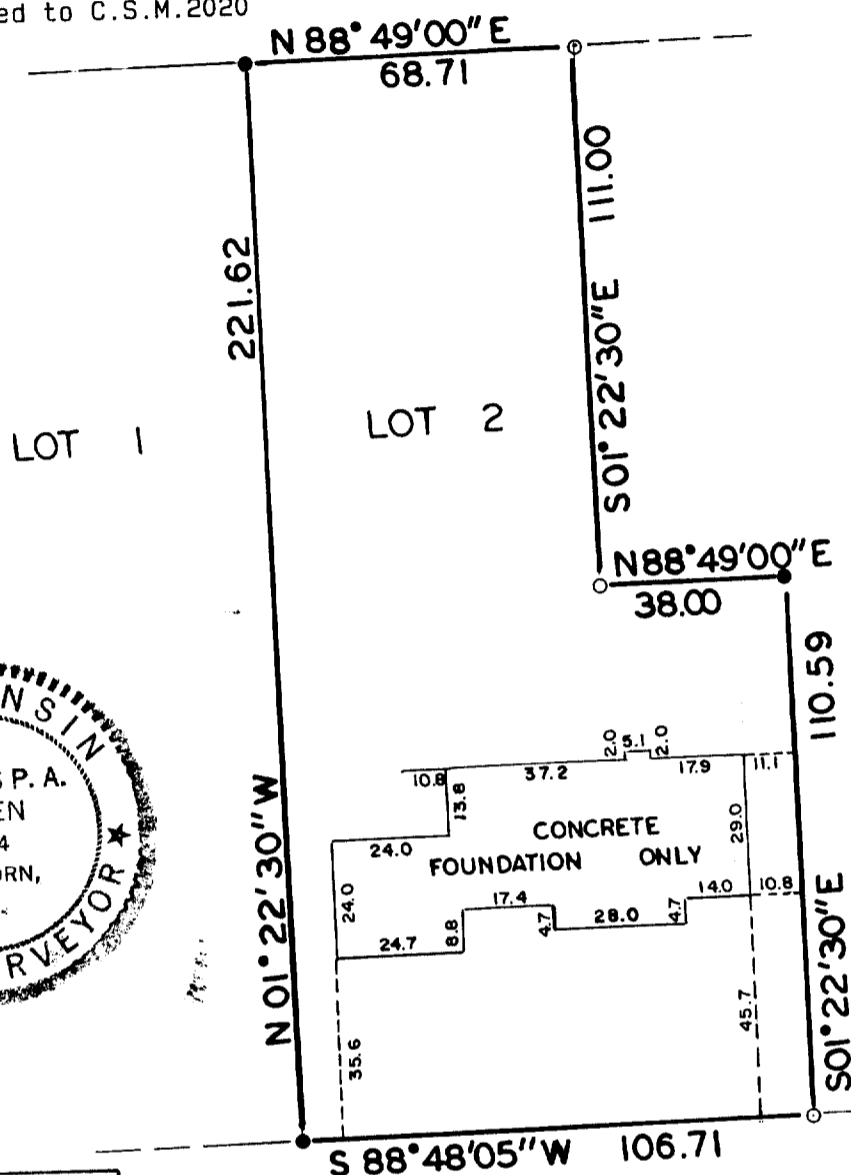

Copyright © 1991 by Jensen Surveying & Mapping S.C.  
All rights reserved. No part of this survey plat may be reproduced or transmitted in any form  
by any means - graphic, electronic, or mechanical, including photocopying, tracing, or infor-  
mation storage and retrieval systems - without permission in writing from Thomas P.A. Jensen.

I, Thomas P.A. Jensen, Wisconsin Registered Land Surveyor, do hereby certify that this  
survey was performed by me, or under my direction, in full compliance with the owner's/agent's  
instructions and Chapter A-E 7 of the Wisconsin Administrative Code ' Minimum Standards For  
Property Surveys ', and that this map is an accurate representation thereof to the best of my  
knowledge and belief.

Note: This survey plat is not  
certified unless signed  
and sealed in red ink.

Thomas P.A. Jensen R.L.S. 1084

## Legend

- ~ Found iron pipe
- ~ Found iron rod

**Jensen Surveying & Mapping S.C.**

45 South Wisconsin Street P.O. Box 322  
Elkhorn, Wisconsin. 53121.  
(414) 723-3434


Mapping date: 9/26/91.

Revisions: \_\_\_\_\_

Sheet 1 of 1 Sheets

Job reference number:

Scale: 1" = 40'

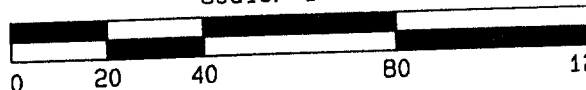

120 2A20200002 1991.166A