
WALWORTH COUNTY SURVEYING & MAPPING

727 HENRY STREET LAKE GENEVA, WISCONSIN 414-248-0505

SUE ANN DRIVE

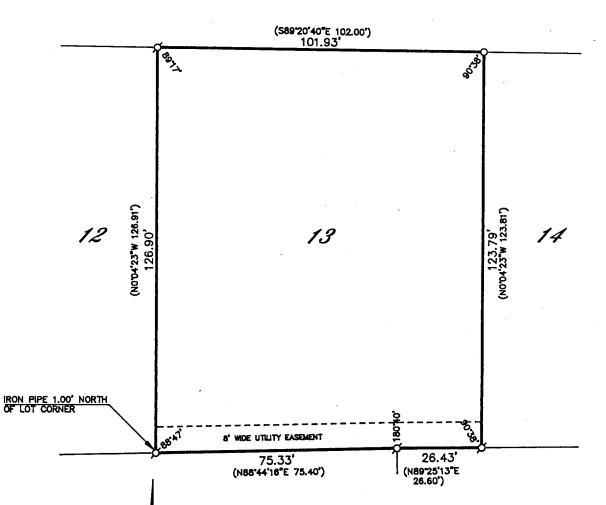

PLAT OF SURVEY OF

LOT 13 IN BARBARA JEAN ESTATES, A SUBDIVISION LOCATED IN THE NE 1/4 OF SECTION 1, T 1 N, R 17 E, IN THE CITY OF LAKE GENEVA, WALWORTH COUNTY, WISCONSIN.

ORDERED BY: REALTY WORLD-TAGGART 756 MAIN STREET

LAKE GENEVA, WISCONSIN

53147

I HEREBY CERTIFY THAT I HAVE SURVEYED THE ABOVE DESCRIBED PROPERTY AND THAT THE ABOVE MAP IS A TRUE REPRESENTATION THEREOF AND SHOWS THE SIZE AND LOCATION OF THE PROPERTY, ITS EXTERIOR BOUNDARIES, THE LOCATION OF ALL VISIBLE STRUCTURES AND DIMENSIONS OF ALL PRINCIPAL BUILDINGS THEREON, BOUNDARY FENCES, APPARENT EASEMENTS, ROADWAYS AND VISIBLE ENCROACHMENTS, IF ANY, TO THE BEST OF MY KNOWLEDGE AND BELIEF.

THIS SURVEY IS MADE FOR THE USE OF THE PRESENT OWNERS OF THE PROPERTY AND ALSO THOSE WHO PURCHASE, MORTGAGE OR GUARANTEE THE TITLE THERETO WITHIN ONE (1) YEAR FROM DATE HEREOF.

ROBERT M. BASTERIWALD
WISCONSIN REGISTERED LAND SURVEYOR, S-1508

MODULAN NEGOTIAL DANS CONTENA, STAGE

Mark 13/92/

NOTE: THIS IS NOT A CERTIFIED COPY UNLESS SEALED.

LEGEND

C-IRON PIPE FOUND

P-IRON ROD FOUND

C-CONCRETE MONUMENT FOUND

O-IRON PIPE PLACED

()-RECORDED AS

SCALE IN FEET 30

60

JAN 1 6