


# ABELL SURVEYING & MAPPING

DELAVER, WISCONSIN 53115

414-728-6737

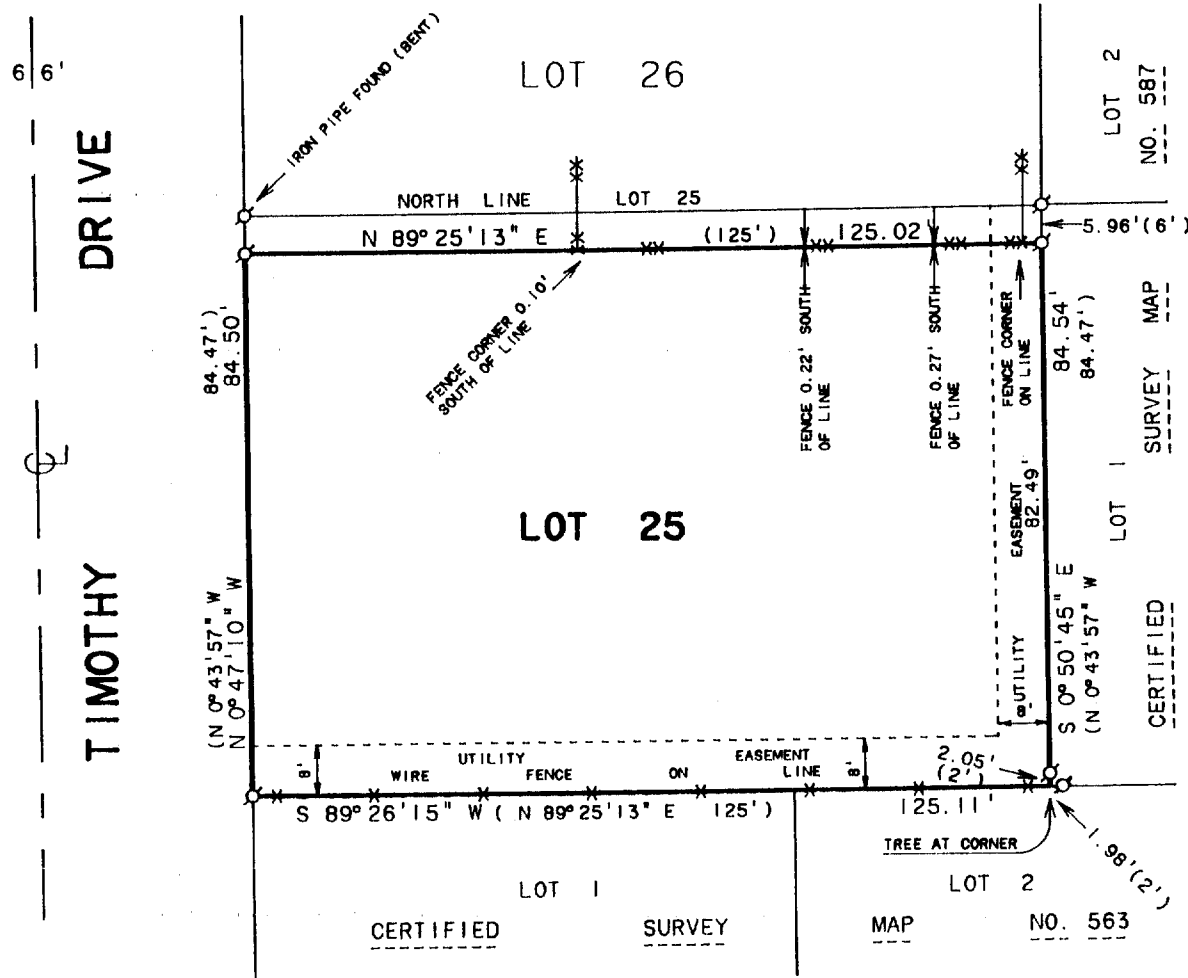


SCALE 1"=30'

## LEGEND

- - IRON PIPE FOUND
- XX - WOOD FENCE
- X - WIRE FENCE
- ( ) - RECORDED AS

## PLAT OF SURVEY OF

LOT 25 OF BARBARA JEAN ESTATES, LOCATED IN  
THE CITY OF LAKE GENEVA, WALWORTH COUNTY,  
WISCONSIN. EXCEPTING THEREFROM THE NORTH  
6 FEET OF SAID LOT 25.

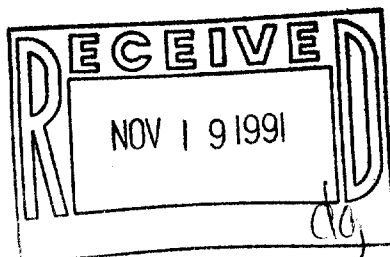

NOTE: BEARINGS ARE REFERENCED TO THE  
RECORDED SUBDIVISION PLAT.

I HEREBY CERTIFY THAT I HAVE SURVEYED THE ABOVE DESCRIBED PROPERTY AND THAT THE  
ABOVE MAP IS A TRUE REPRESENTATION THEREOF AND SHOWS THE SIZE AND LOCATION OF  
THE PROPERTY, ITS EXTERIOR BOUNDARIES, THE LOCATION OF ALL VISIBLE STRUCTURES  
AND DIMENSIONS OF ALL PRINCIPAL BUILDINGS THEREON, BOUNDARY FENCES, APPARENT  
EASEMENTS, ROADWAYS AND VISIBLE ENCROACHMENTS, IF ANY, TO THE BEST OF MY  
KNOWLEDGE AND BELIEF.

ORDERED BY: KEEFE REAL ESTATE  
704 MAIN STREET  
LAKE GENEVA, WI. 53147

THIS SURVEY IS MADE FOR THE USE OF THE PRESENT OWNERS OF THE PROPERTY, AND ALSO  
THOSE WHO PURCHASE, MORTGAGE, OR GUARANTEE THE TITLE THERETO WITHIN ONE (1) YEAR  
FROM DATE HEREOF.

*David F. Abell*  
DAVID F. ABELL

WISCONSIN REGISTERED LAND SURVEYOR, S-1596

*September 4, 1991*  
DATE

JOB NUMBER - 91185

NOTE: THIS IS NOT A CERTIFIED COPY UNLESS SEALED.

007-1317

25-25