ABELL


SURVEYING & MAPPING

DELAVAN, WISCONSIN 53115 414-728-6737

GEORGE

STREET



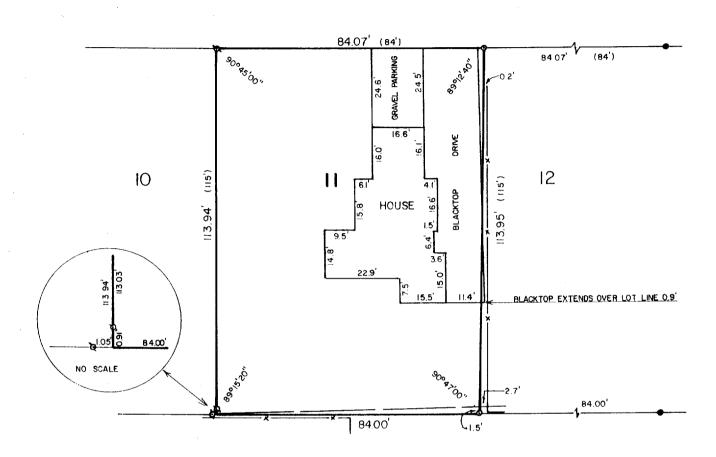

PLAT OF SURVEY OF

LOT 11 OF KOHN'S SUBDIVISION LOCATED IN THE CITY OF LAKE GENEVA, WALWORTH COUNTY, WISCONSIN.

ORDERED BY:

KEEFE REAL ESTATE ORDERED BY: 704 MAIN STREET ECEIVE LAKE GENEVA, WI 53147

FEB | 2 1993

VACATION PROPERTIES NETWORK 159 BROAD STREET LAKE GENEVA, WI. 53147



SCALE -1"=30"

LEGEND

- IRON PIPE FOUND

- IRON ROD FOUND

) - RECORDED AS

• - IRON PIPE SET, FOUND 10/5/92

FENCE

OVERHEAD UTILITY LINES

PRINCIPAL BUILDINGS THEREON, BOUNDARY FENCES, APPARENT EASEMENTS, ROADWAYS AND VISIBLE ENCROACHMENTS, IF ANY, TO THE BEST OF MY KNOWLEDGE AND BELIEF.

I HEREBY CERTIFY THAT I HAVE SURVEYED THE ABOVE DESCRIBED PROPERTY AND THAT THE ABOVE

MAP IS A TRUE REPRESENTATION THEREOF AND SHOWS THE SIZE AND LOCATION OF THE PROPERTY, ITS EXTERIOR BOUNDARIES, THE LOCATION OF ALL VISIBLE STRUCTURES AND DIMENSIONS OF ALL

THIS SURVEY IS MADE FOR THE USE OF THE PRESENT OWNERS OF THE PROPERTY, AND ALSO THOSE WHO PURCHASE, MORTGAGE, OR GUARANTEE THE TITLE THERETO WITHIN ONE (1) YEAR FROM DATE HEREOF.

DAVID F. ABELL

WISCONSIN REGISTERED LAND SURVEYOR, S-1596

REVISED: 10/5/92 JOB NUMBER - 88255 THIS IS NOT A CERTIFIED COPY UNLESS SEALED.

ZK-10