
KOLB LAND CONSULTING, INC.

LAND SURVEYING . SUBDIVIDING . LAND PLANIMING

929 WILLIAMS STREET

LAKE GENEVA, WISCONSIN 53147

414 248-3697

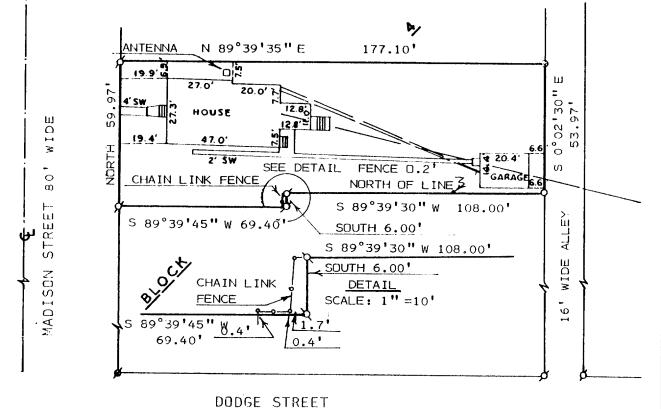

PLAT OF SURVEY OF

PART OF LOT 11, BLOCK 4 OF GOODSELL'S SUBDIVISION OF BLOCKS 3 & 4 OF THE ORIGINAL PLAT OF THE CITY OF LAKE GENEVA, WALWORTH COUNTY, WISCONSIN.

NOTE: BEARINGS ARE ASSUMED AS SHOWN ON RECORDED SURVEY RECORDS.

ORDERED BY: ST. FRANCIS DE SALES
CATHOLIC CHURCH
148 MAIN STREET
LAKE GENEVA, WI. 53147



SCALE: 1" = 40' LEGEND

ø- IRON PIPE FOUND

O- IRON PIPE SET

Ø- SPIKE FOUND

SW- SIDEWALK

MAR 2 5 1993

I HEREBY CERTIFY THAT I HAVE SURVEYED THE ABOVE DESCRIBED PROPERTY AND THAT THE ABOVE MAP IS A TRUE REPRESENTATION THEREOF AND SHOWS THE SIZE AND LOCATION OF THE PROPERTY, ITS EXTERIOR BOUNDARIES, THE LOCATION OF ALL VISIBLE STRUCTURES AND DIMENSIONS OF ALL PRINCIPAL BUILDINGS THEREON, BOUNDARY FENCES, APPARENT EASEMENTS, ROADWAYS AND VISIBLE ENCROACHMENTS, IF ANY, TO THE BEST OF MY KNOWLEDGE AND BELIEF.

THIS SURVEY IS MADE FOR THE USE OF THE PRESENT OWNERS OF THE PROPERTY AND ALSO THOSE WHO PURCHASE, MORTGAGE OR GUARANTEE THE TITLE THERETO WITHIN ONE (1) YEAR FROM DATE HEREOF.

SURVEY NOT VALID UNLESS SURVEYOR'S SIGNATURE IS IN RED.

HAROLD II. KOLB

WISCONSIN REGISTERED LAND SURVEYOR, S-187

DATE JANUARY 7, 1993

REVISED ___

200 2GD. 2DA