


WALWORTH COUNTY
SURVEYING & MAPPING
727 HENRY STREET
LAKE GENEVA, WISCONSIN
414-248-0505

PLAT OF SURVEY OF

LOT 12, BLOCK 19 OF LAKE GENEVA CRAWFORD MANUFACTURING
CO.'S ADDITION TO THE VILLAGE OF GENEVA, NOW CITY OF LAKE
GENEVA, WALWORTH COUNTY, WISCONSIN.


ORDERED BY: ALLEN, HARRISON, WILLIAMS, MCDONELL & SWATEK
527 CENTER STREET
LAKE GENEVA, WISCONSIN
53147

GRAPHIC SCALE

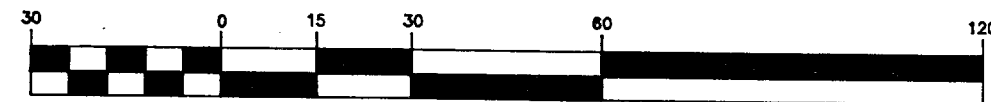

(IN FEET)
1 inch = 30 ft.

Ø—IRON PIPE FOUND
Ø—IRON ROD FOUND
■—CONCRETE MONUMENT FOUND
O—IRON PIPE PLACED
()—RECORDED AS

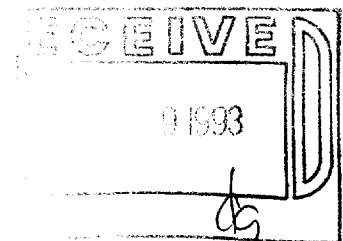


I HEREBY CERTIFY THAT I HAVE SURVEYED THE ABOVE DESCRIBED
PROPERTY AND THAT THE ABOVE MAP IS A TRUE REPRESENTATION
THEREOF AND SHOWS THE SIZE AND LOCATION OF THE PROPERTY,
ITS EXTERIOR BOUNDARIES, THE LOCATION OF ALL VISIBLE STRUCTURES
AND DIMENSIONS OF ALL PRINCIPAL BUILDINGS THEREON, BOUNDARY
FENCES, APPARENT EASEMENTS, ROADWAYS AND VISIBLE ENCROACH-
MENTS, IF ANY, TO THE BEST OF MY KNOWLEDGE AND BELIEF.

THIS SURVEY IS MADE FOR THE USE OF THE PRESENT OWNERS OF
THE PROPERTY AND ALSO THOSE WHO PURCHASE, MORTGAGE OR
QUARANTEE THE TITLE THERETO WITHIN ONE (1) YEAR FROM DATE
HEREOF.

Robert M. Baerenwald
ROBERT M. BAERENWALD
WISCONSIN REGISTERED LAND SURVEYOR, S-1508

March 18, 1993
DATE 008 NO. 3765

NOTE: THIS IS NOT A CERTIFIED COPY UNLESS SEALED.

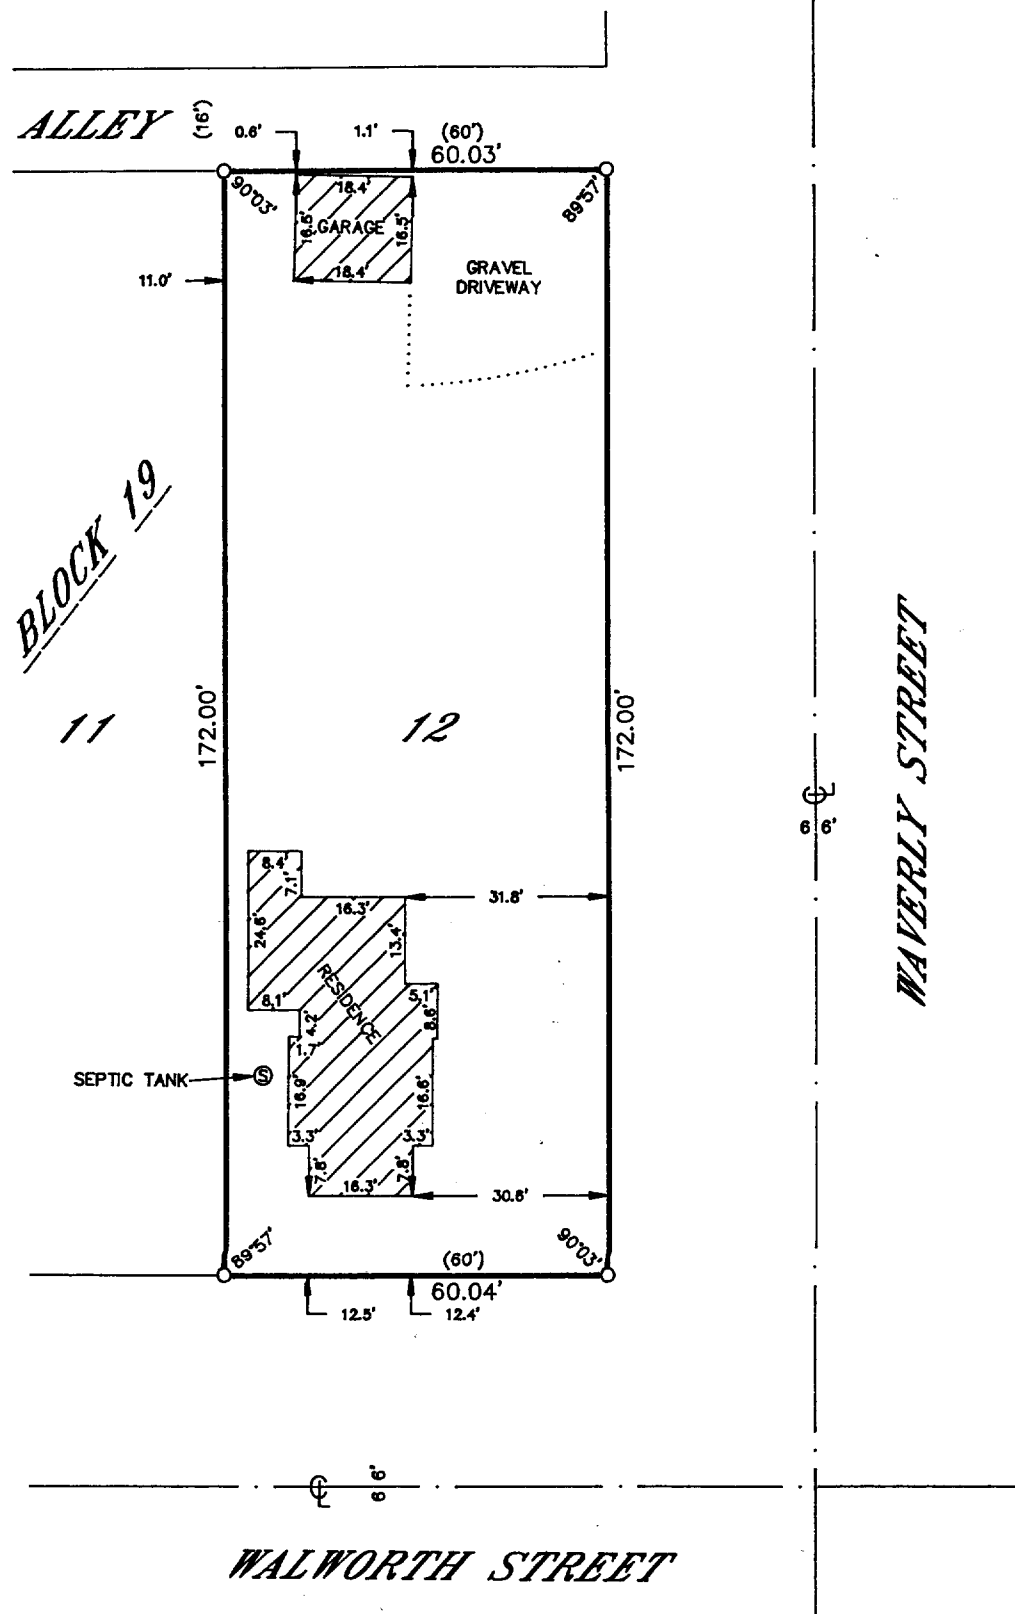

2610-110

607-1431