

WALWORTH COUNTY SURVEYING & MAPPING 727 HENRY STREET LAKE GENEVA, WISCONSIN 414-248-0505

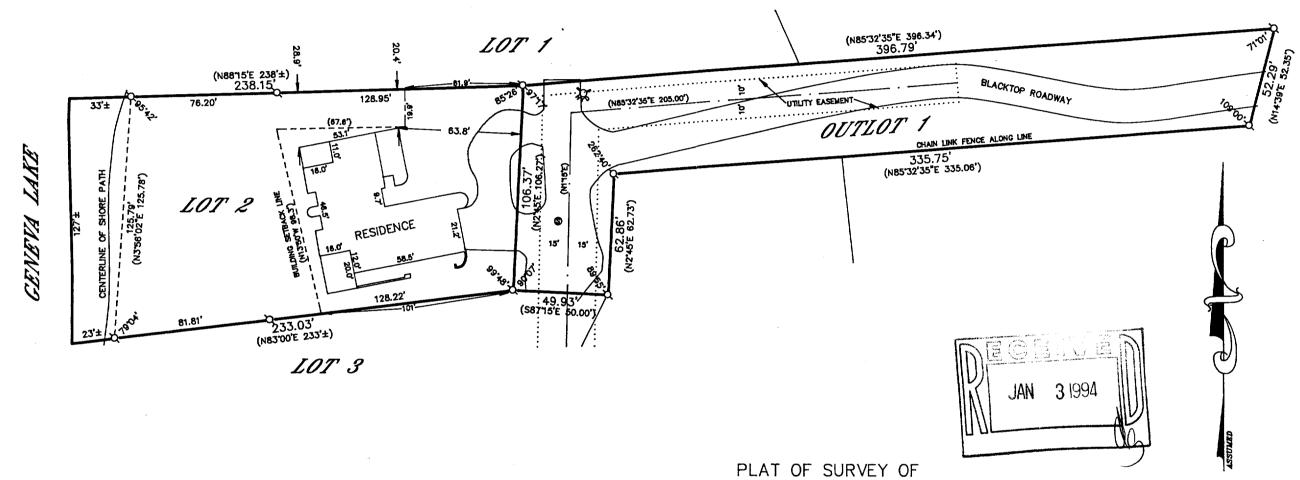

GRAPHIC SCALE

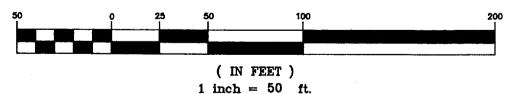

Ø-IRON PIPE FOUND
Ø-IRON ROD FOUND

CONCRETE MONUMENT FOUND
O-IRON PIPE PLACED
()-RECORDED AS

LOT 2 AND AN UNDIVIDED 1/3 INTEREST IN OUTLOT 1 OF CERTIFIED SURVEY NO. 1240, BEING PART OF THE WEST 1/2 OF SECTION 1, T 1 N, R 17 E, CITY OF LAKE GENEVA, WALWORTH COUNTY, WISCONSIN, RECORDED SEPTEMBER 1, 1982 IN VOLUME 5 OF CERTIFIED SURVEYS ON PAGE 359 AS DOCUMENT NO. 81815

ORDERED BY: KEEFE REAL ESTATE
704 MAIN STREET
LAKE GENEVA, WISCONSIN
53147

I HEREBY CERTIFY THAT I HAVE SURVEYED THE ABOVE DESCRIBED PROPERTY AND THAT THE ABOVE MAP IS A TRUE REPRESENTATION THEREOF AND SHOWS THE SIZE AND LOCATION OF THE PROPERTY, ITS EXTERIOR BOUNDARIES, THE LOCATION OF ALL VISIBLE STRUCTURES AND DIMENSIONS OF ALL PRINCIPAL BUILDINGS THEREON, BOUNDARY FENCES, APPARENT EASEMENTS, ROADWAYS AND VISIBLE ENGROACHMENTS, IF ANY, TO THE BEST OF MY KNOWLEDGE AND BELIEF.

THIS SURVEY IS MADE FOR THE USE OF THE PRESENT OWNERS OF THE PROPERTY AND ALSO THOSE WHO PURCHASE, MORTGAGE OR QUARANTEE THE TITLE THERETO WITHIN ONE (1) YEAR FROM DATE HEREOF.

ROBERT M. BAERENWALD
WISCONSIN REGISTERED LAND SURVEYOR, S-1508

DATE SUPPLE 5, 1993

NOTE: THIS IS NOT A CERTIFIED COPY UNLESS SEALED.