KOLB LAND CONSULTING, INC.


LAND SURVEYING . SUBDIVIDING . LAND PLANTING

929 WILLIAMS STREET

TARE GEHEVA, WISCONSTIT 53147

414 248 -3697

GRANT STREET 60' WIDE

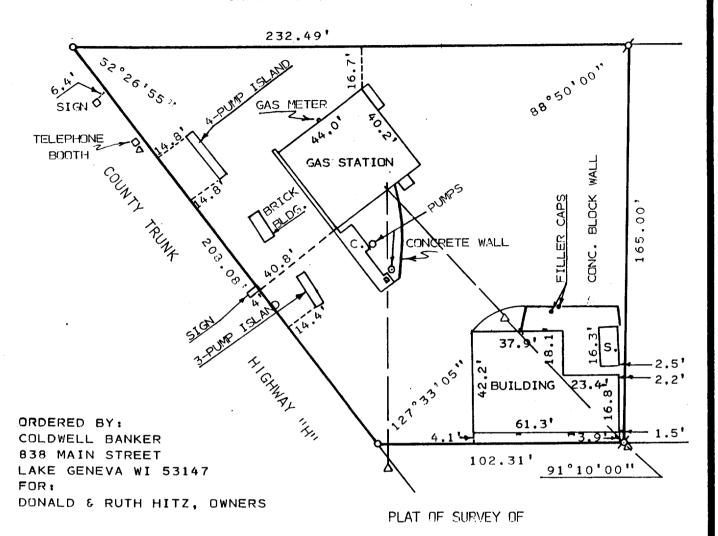


LOTS 8 AND 9, BLOCK 3 OF WHEELERS ADDITION TO THE CITY OF LAKE GENEVA, WALWORTH COUNTY, WISCONSIN.

LEGEND

- Δ UTILITY POLE
- OVERHEAD UTILITY LINE
- Ø- IRON PIPE FOUND
- O IRON PIPE SET
- - IRON ROD SET
- C- CONCRETE S- SHED



SCALE: 1" = 40"

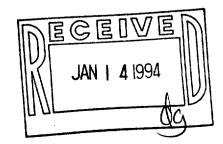

I HEREBY CERTIFY THAT I HAVE SURVEYED THE ABOVE DESCRIBED PROPERTY AND THAT THE ABOVE MAP IS A TRUE REPRESENTATION THEREOF AND SHOWS THE SIZE AND LOCATION OF THE PROPERTY, ITS EXTERIOR BOUNDARIES, THE LOCATION OF ALL VISIBLE STRUCTURES AND DIMENSIONS OF ALL PRINCIPAL BUILDINGS THEREON, BOUNDARY FENCES, APPARENT EASEMENTS, ROADWAYS AND VISIBLE ENCROACHMENTS, IF ANY, TO THE BEST OF MY KNOWLEDGE AND BELIEF.

THIS SURVEY IS MADE FOR THE USE OF THE PRESENT OWNERS OF THE PROPERTY AND ALSO THOSE WHO PURCHASE, MORTGAGE OR GUARANTEE THE TITLE THERETO WITHIN ONE (1) YEAR FROM DATE HEREOF.

SURVEY NOT VALID UNLESS SURVEYOR'S SIGNATURE IS IN RED.

HAROLD H. KOLB

WISCONSIN REGISTERED LAND SURVEYOR, S-187

DATE NOVEMBER 24, 1993

REVISED_

REVISED ...

LG/46

007-1489