


KOLB LAND CONSULTING, INC.  
LAND SURVEYING • SUBDIVIDING • LAND PLANNING

929 WILLIAMS STREET LAKE GENEVA, WISCONSIN 53147 414 240 3697

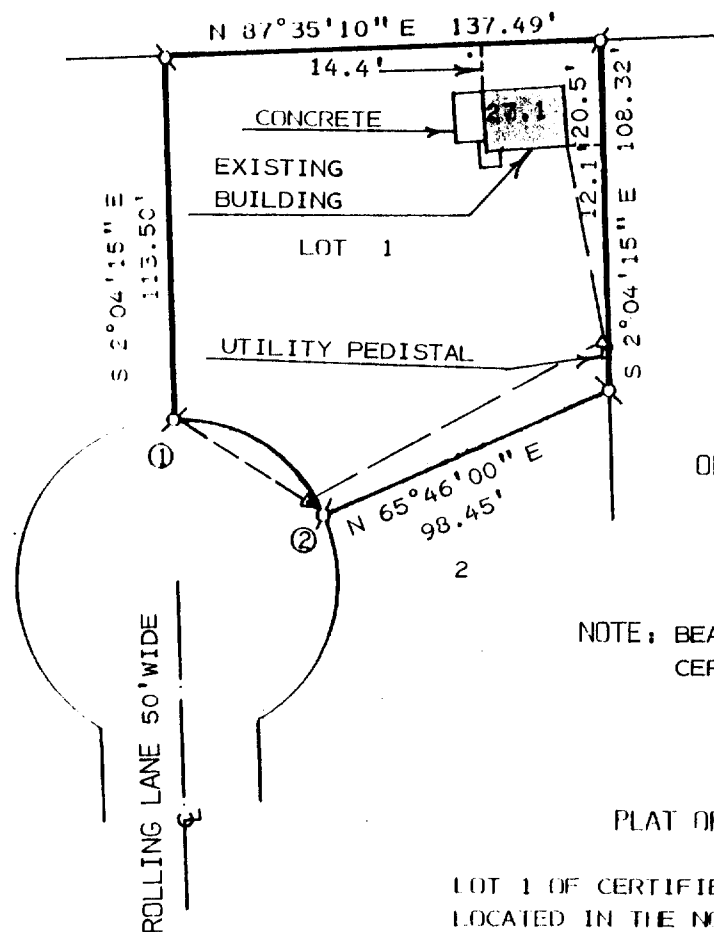

CURVE DATA  
CHORD 1-2  
BEARING S 58°09'10" E  
LENGTH 55.80'  
RADIUS 50.00'

ORDERED BY: CLARENCE JOHNSON  
1185 ROLLING LANE  
LAKE GENEVA, WI. 53147

NOTE: BEARINGS ARE ASSUMED AS SHOWN ON  
CERTIFIED SURVEY MAP NO. 1406.

PLAT OF SURVEY OF

LOT 1 OF CERTIFIED SURVEY MAP NO. 1406  
LOCATED IN THE NORTHEAST 1/4 OF SECTION  
1, T1N, R17E, CITY OF LAKE GENEVA, WISCONSIN.




SCALE: 1" = 60'

LEGEND

⊕ - IRON PIPE FOUND

Δ - UTILITY POLE

— — — OVERHEAD UTILITY LINE

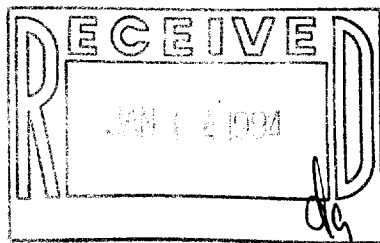

I HEREBY CERTIFY THAT I HAVE SURVEYED THE  
ABOVE DESCRIBED PROPERTY AND THAT THE ABOVE  
MAP IS A TRUE REPRESENTATION THEREOF AND  
SHOWS THE SIZE AND LOCATION OF THE PROPERTY,  
ITS EXTERIOR BOUNDARIES, THE LOCATION OF ALL  
VISIBLE STRUCTURES AND DIMENSIONS OF ALL  
PRINCIPAL BUILDINGS THEREON, BOUNDARY FENCES,  
APPARENT EASEMENTS, ROADWAYS AND VISIBLE  
ENCROACHMENTS, IF ANY, TO THE BEST OF MY  
KNOWLEDGE AND BELIEF.

THIS SURVEY IS MADE FOR THE USE OF THE  
PRESENT OWNERS OF THE PROPERTY, AND ALSO  
THOSE WHO PURCHASE, MORTGAGE, OR GUARANTEE  
THE TITLE THERETO WITHIN ONE (1) YEAR FROM  
DATE HEREOF. SURVEY NOT VALID UNLESS SUR-  
VEYOR'S SIGNATURE IS IN RED.

HAROLD H. KOLB

WISCONSIN REGISTERED LAND SURVEYOR, S-187

DATE JUNE 25, 1993

REVISED

REVISED