KOLB LAND CONSULTING, INC.


LAND SURVEYING . SUBDIVIDING . LAND PLANNING

LAKE GENEVA, WISCONSIN 53147

W α

WHITEWATER, WISCONSIN 53190

PLEASANT STREET-60' WIDE

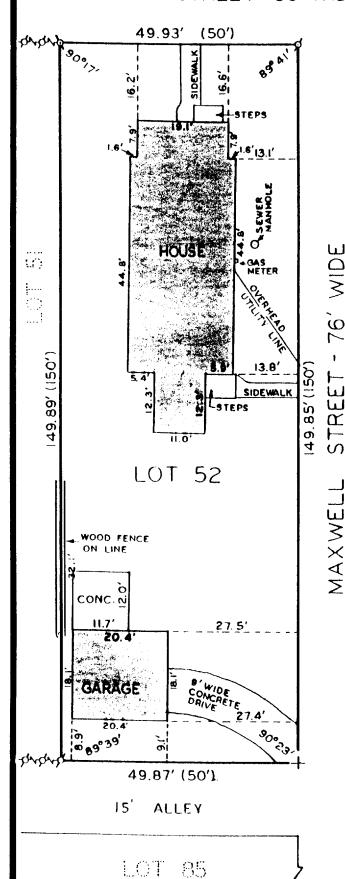

PLAT OF SURVEY OF

LOT 52 OF COLUMBIAN SUBDIVISION, LOCATED IN THE CITY OF LAKE GENEVA, WALWORTH COUNTY, WISCONSIN.

ORDERED BY: KEEFE REAL ESTATE INC. 704 MAIN STREET LAKE GENEVA, WI. 53147



Ø - IRON PIPE FOUND

• - IRON PIPE SET +- CUT CROSS IN CONCRETE

()- AS RECORDED

I, HEREBY CERTIFY THAT I HAVE SURVEYED THE ABOVE DESCRIBED PROPERTY AND THAT THE ABOVE MAP IS A TRUE REPRESENTATION THEREOF AND SHOWS THE SIZE AND LOCA-TION OF THE PROPERTY, ITS EXTERIOR BOUNDARIES, THE LOCATION OF ALL VISIBLE STRUCTURES AND DIMENSIONS OF ALL PRINCIPAL BUILDINGS THEREON, BOUNDARY FENCES, APPARENT EASEMENTS, ROADWAYS AND VISIBLE ENCROACHMENTS, IF ANY.

THIS SURVEY IS MADE FOR THE USE OF THE PRESENT OWNERS OF THE PROPERTY, AND ALSO THOSE WHO PURCHASE, MORTGAGE, OR GUARANTEE THE TITLE THERETO WITH-IN ONE (1) YEAR FROM THE DATE HEREOF. NOTE: SURVEY NOT VALID UNLESS SURVEYOR'S SIGNATURE IS IN RED.

HAROLD H. KOLB WISCONSIN REGISTERED LAND SURVEYOR, S-187

JULY 28, 1993 DATE _