


**ABELL  
SURVEYING & MAPPING**  
DELAYAN, WISCONSIN 53115  
414-728-6737

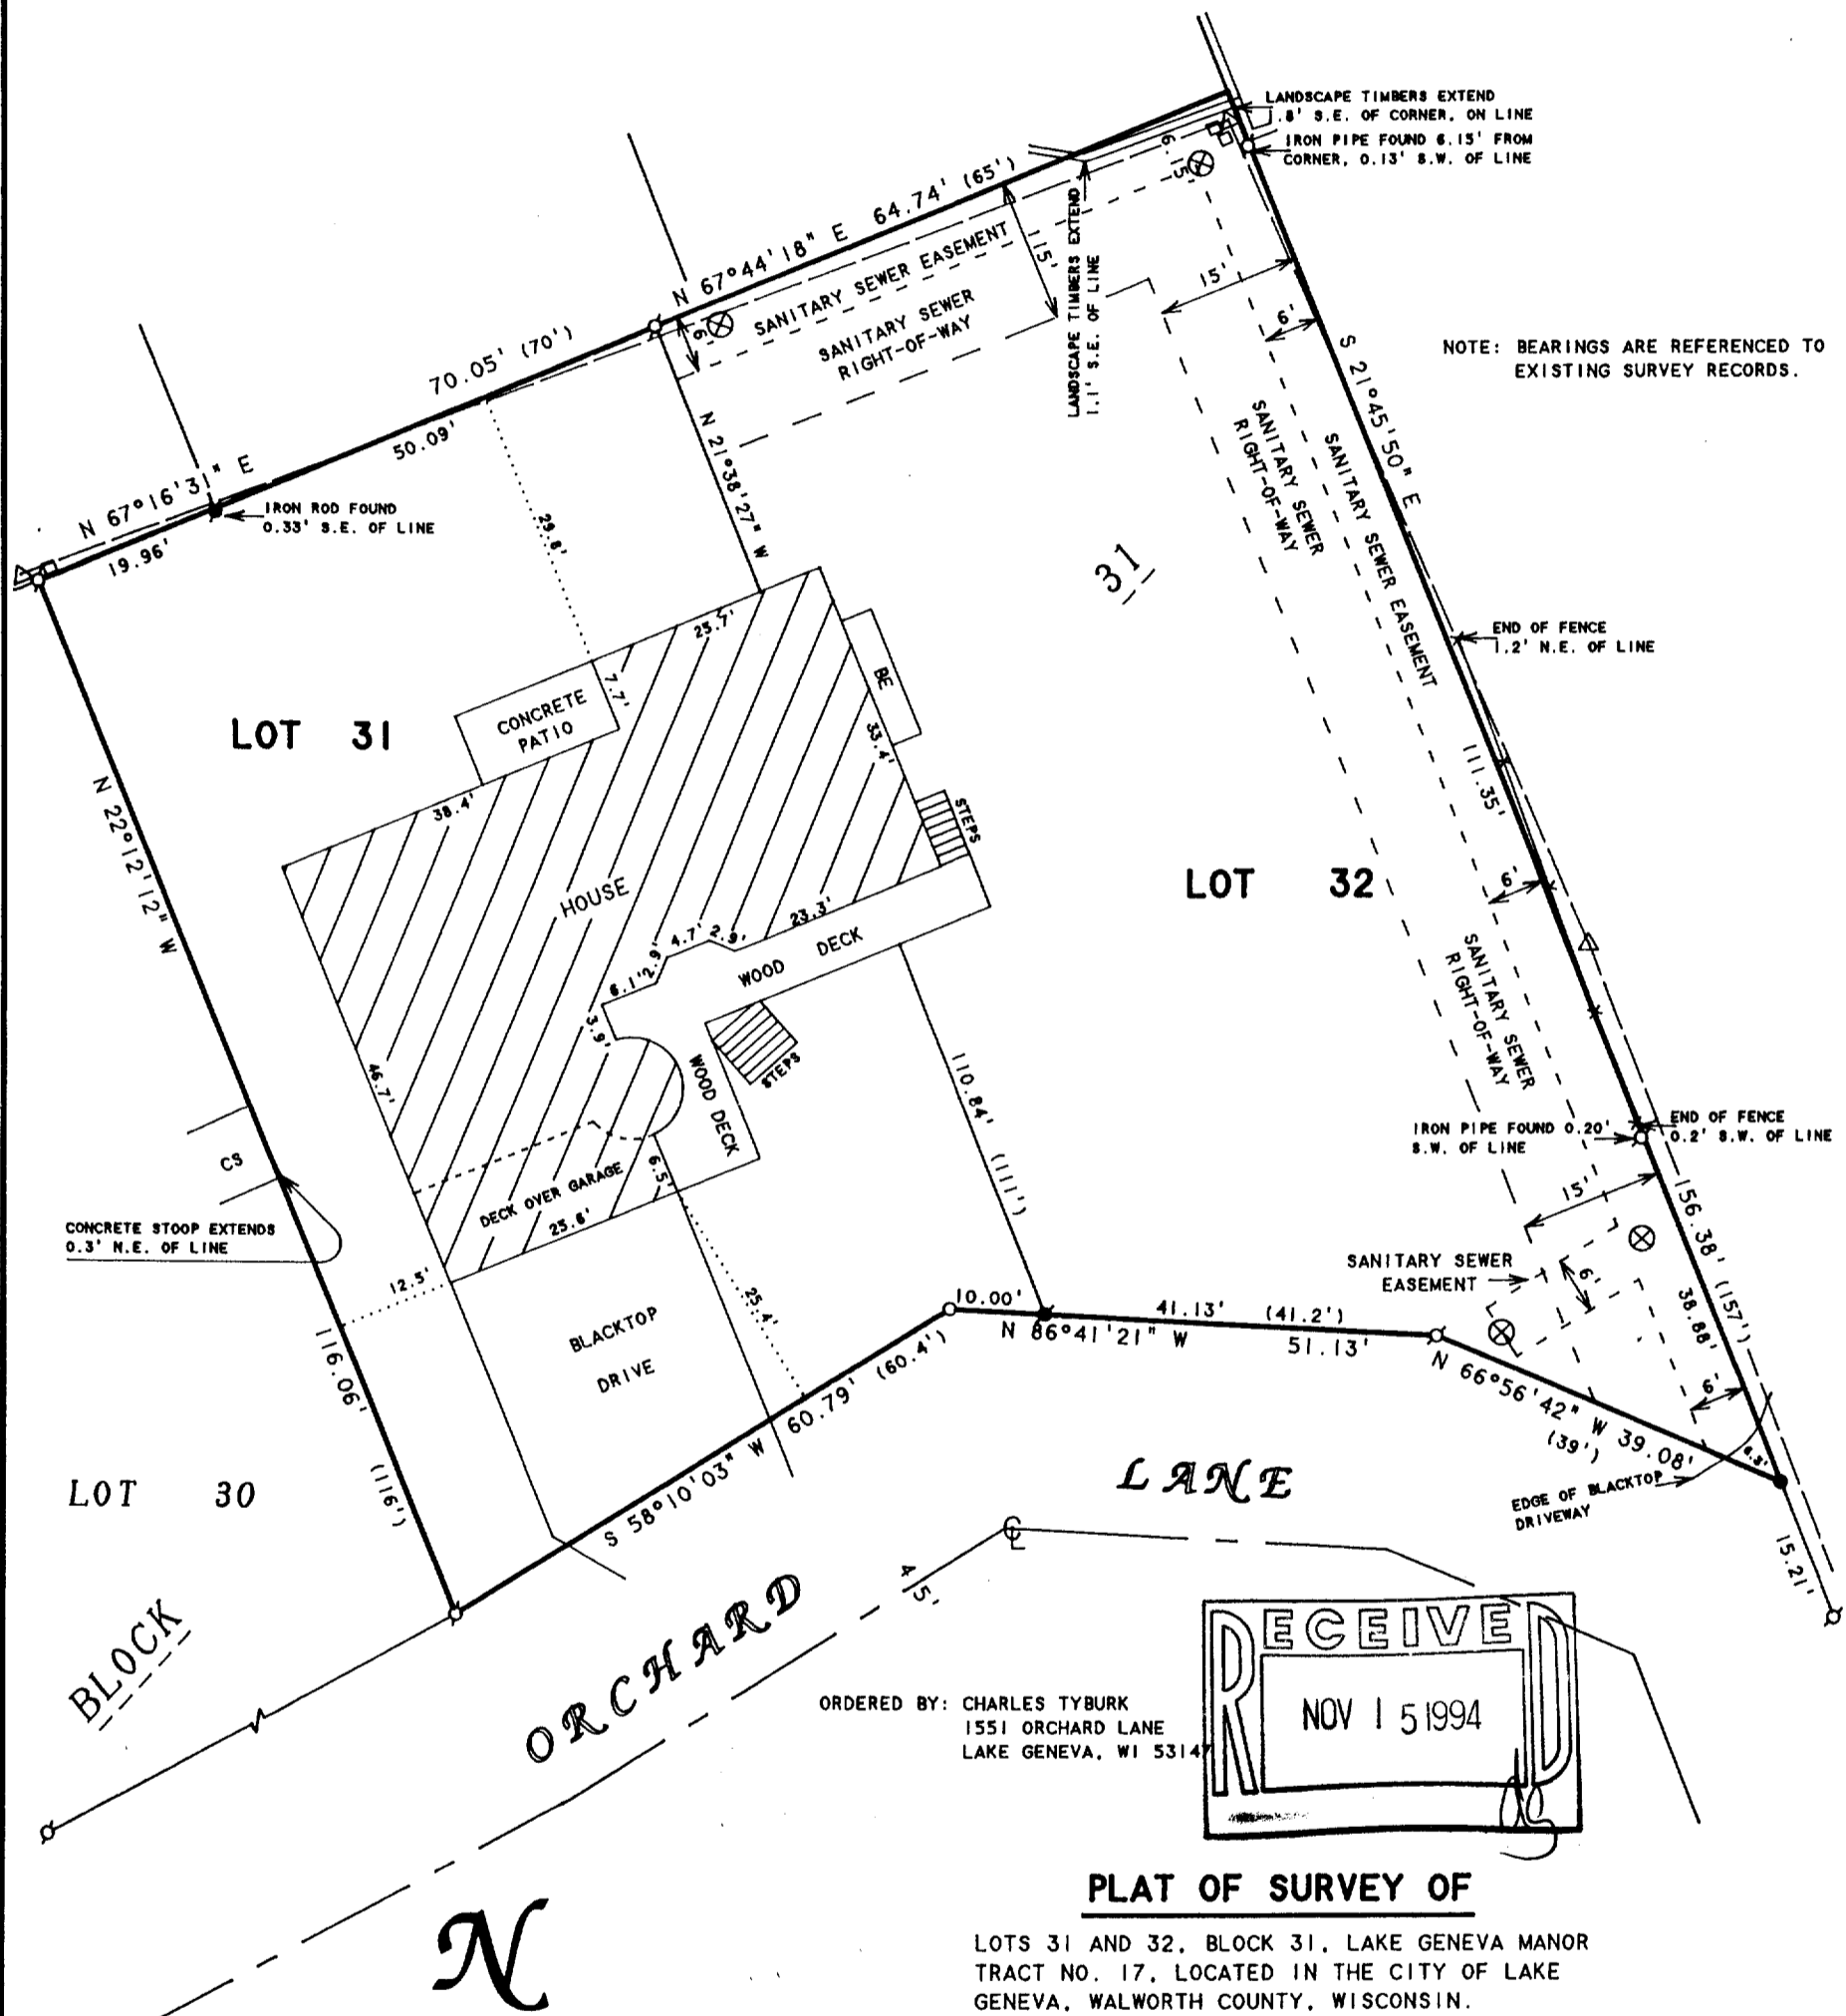

I HEREBY CERTIFY THAT I HAVE SURVEYED THE ABOVE DESCRIBED PROPERTY AND THAT THE ABOVE MAP IS A TRUE REPRESENTATION THEREOF AND SHOWS THE SIZE AND LOCATION OF THE PROPERTY, ITS EXTERIOR BOUNDARIES, THE LOCATION OF ALL VISIBLE STRUCTURES AND DIMENSIONS OF ALL PRINCIPAL BUILDINGS THEREON, BOUNDARY FENCES, APPARENT EASEMENTS, ROADWAYS AND VISIBLE ENCROACHMENTS, IF ANY, TO THE BEST OF MY KNOWLEDGE AND BELIEF.

THIS SURVEY IS MADE FOR THE USE OF THE PRESENT OWNERS OF THE PROPERTY, AND ALSO THOSE WHO PURCHASE, MORTGAGE, OR GUARANTEE THE TITLE THERETO WITHIN ONE (1) YEAR FROM DATE HEREON.

*David F. Abell*

DAVID F. ABELL  
WISCONSIN REGISTERED LAND SURVEYOR, S-1596

June 17, 1994

DATE JOB NUMBER - 94073  
NOTE: THIS IS NOT A CERTIFIED COPY UNLESS SEALED.

007-1523

ZLM-85  
ZLM-86

- LEGEND**
- ⊙ - IRON PIPE FOUND
  - - IRON ROD FOUND
  - - IRON ROD SET
  - - PK NAIL SET
  - △ - UTILITY POLE
  - - OVERHEAD UTILITY LINES
  - - UTILITY PED.
  - - WIRE FENCE
  - ⊗ - MANHOLE COVER
  - CS - CONCRETE STOOP
  - BE - BASEMENT ENTRY
  - ( ) - RECORDED AS