



AMERICAN SURVEYING COMPANY, INC.


LAND SURVEYORS

12207 C.T.H. "K"
FRANKSVILLE, WISCONSIN 53126
TEL. NO. (414) 835-4774

PLAT OF SURVEY

PREPARED FOR: WIMMER BROTHERS
DESCRIPTION:

LOT 1 OF "GENEVA EAST", BEING A REDIVISION OF LOT NUMBER 1 OF CERTIFIED SURVEY MAP NO. 2010. BEING PART OF THE NORTHEAST 1/4 OF THE SOUTHWEST 1/4 AND THE NORTHWEST 1/4 OF THE SOUTHEAST 1/4 OF SECTION 31, TOWN 2 NORTH, RANGE 18 EAST, IN THE CITY OF LAKE GENEVA, COUNTY OF WALWORTH, STATE OF WISCONSIN.

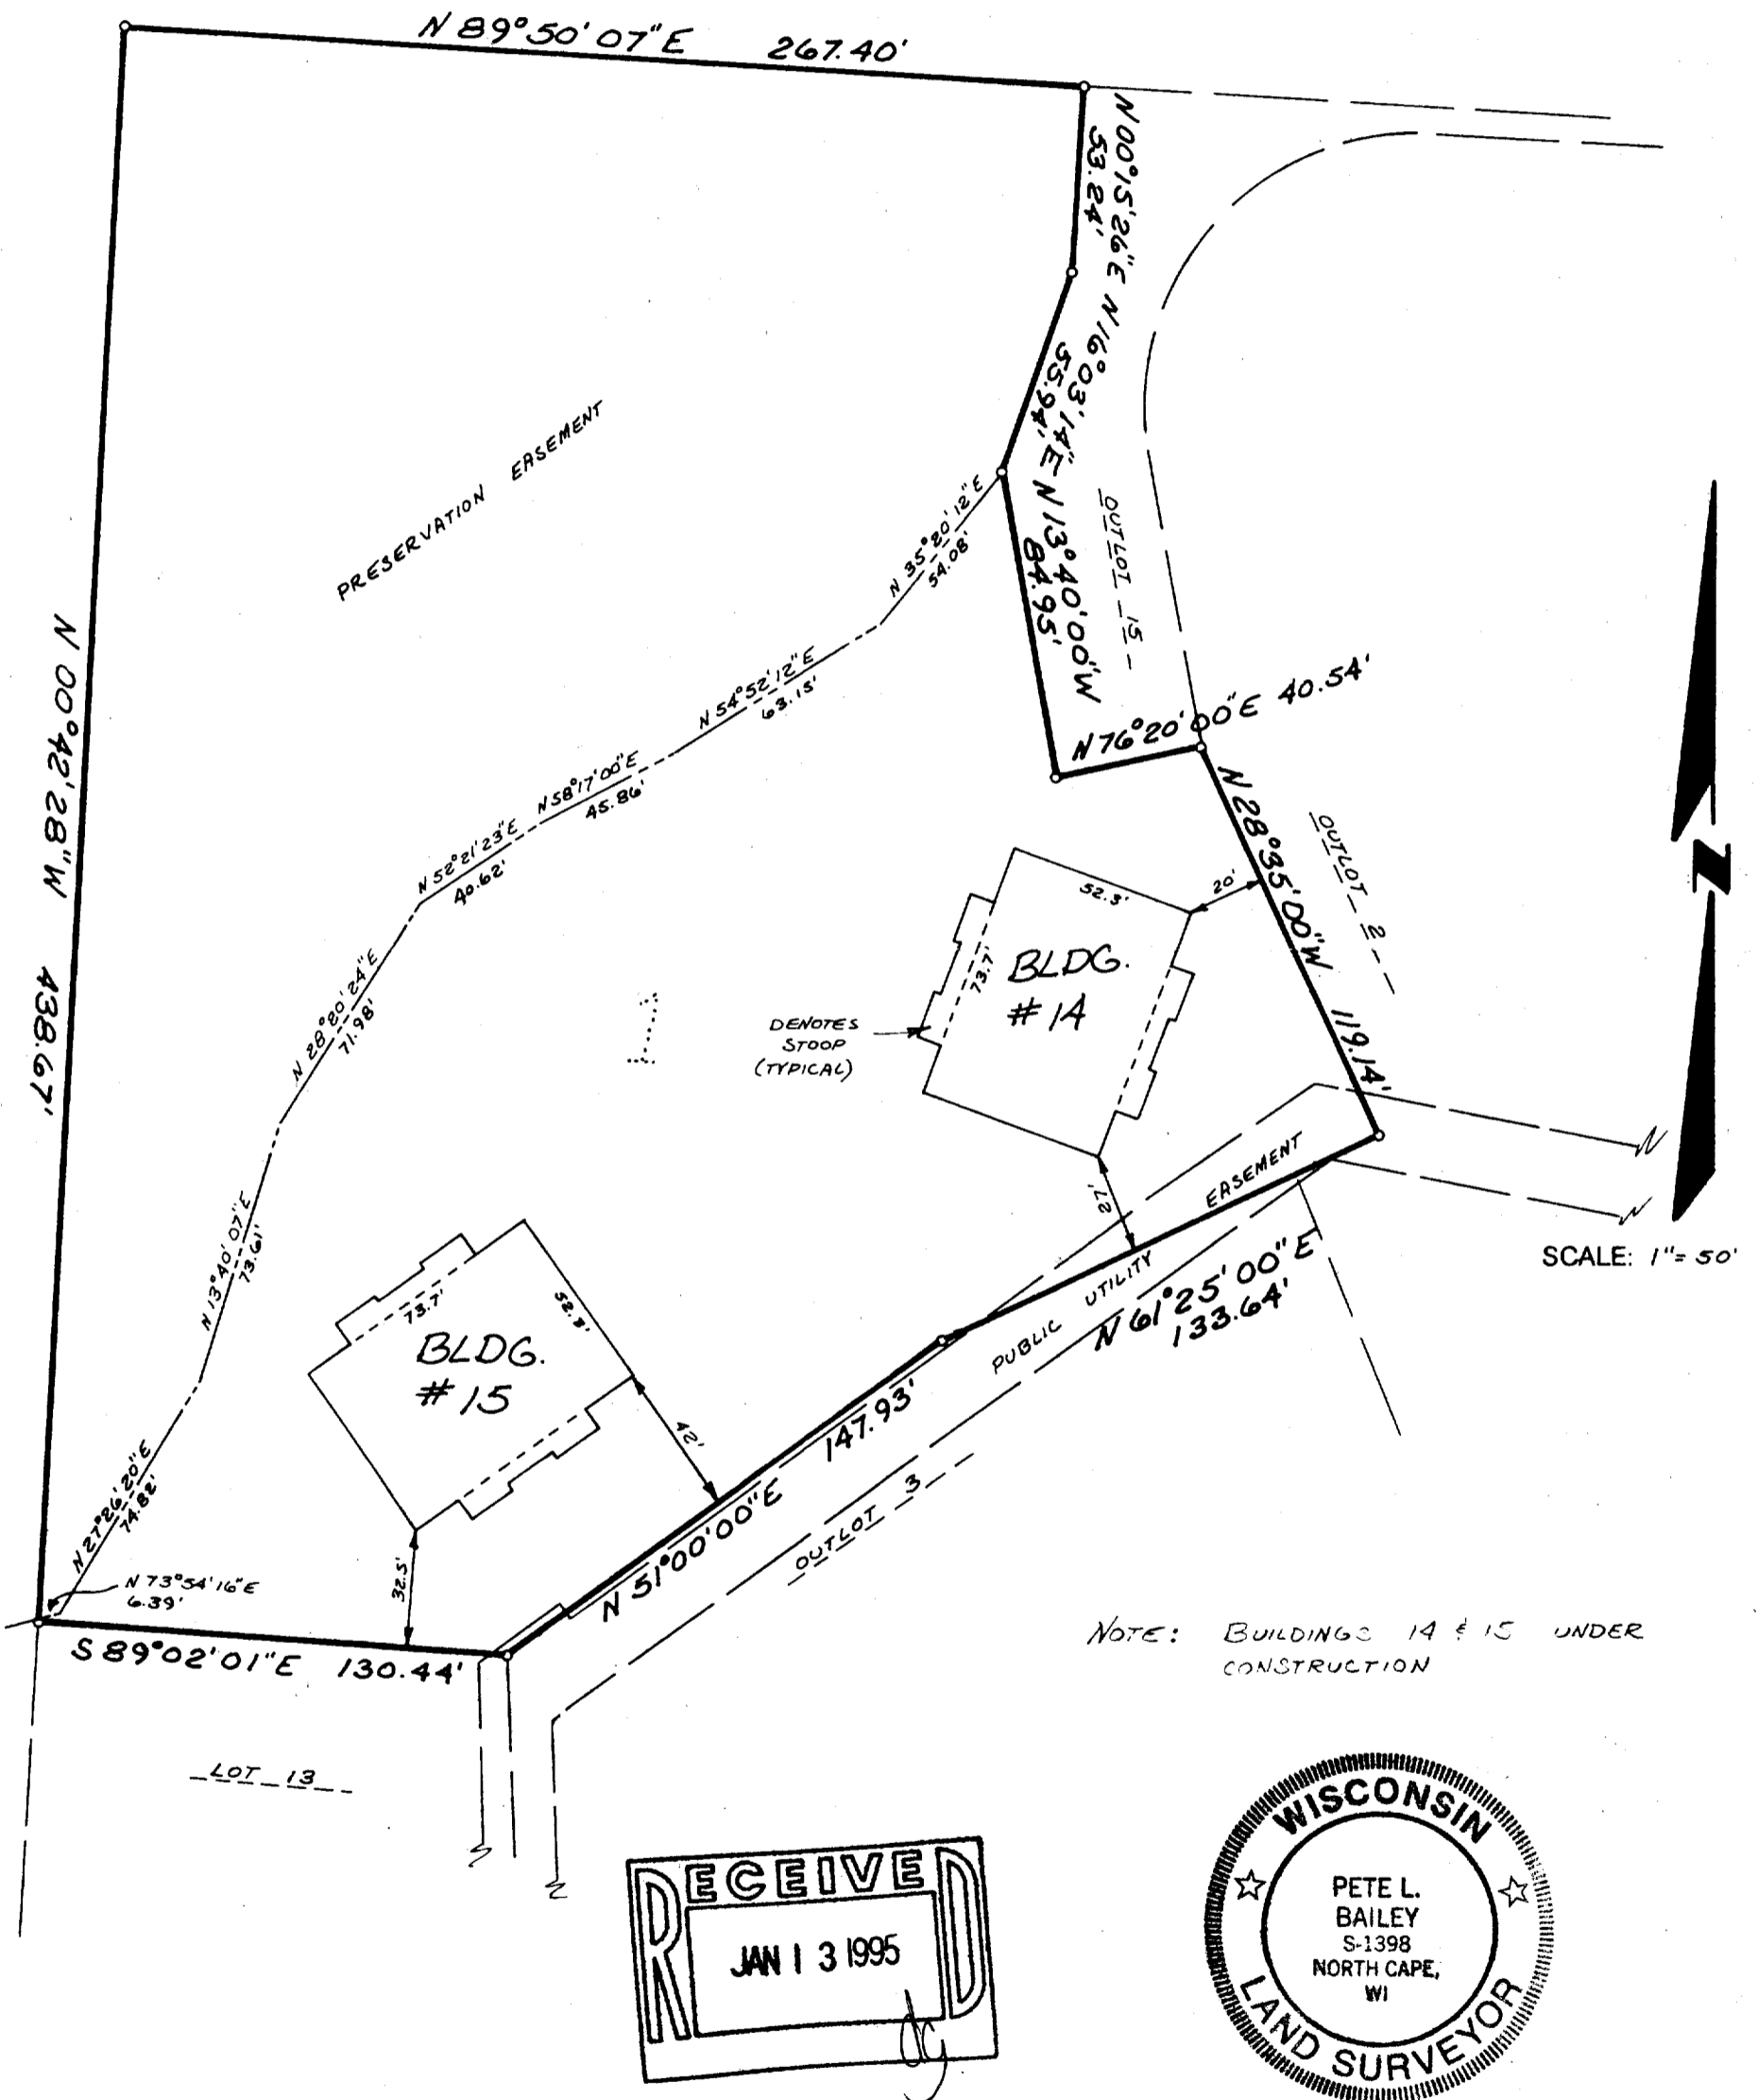

RECEIVED
JAN 13 1995



STATE OF WISCONSIN
COUNTY OF RACINE

The above described property has been surveyed under my direction and the above map is a correct representation thereof.

Dated at NORTH CAPE, this 1ST day of DECEMBER, 19 94. Recertified _____

Pete L. Bailey
Registered Land Surveyor

JOB NO.

BADGER BLUEPRINT CO. 584073

ZGE-1.

007-1543