



HAROLD H. KOLB
REGISTERED PROFESSIONAL LAND SURVEYOR
LAKE GENEVA, WISCONSIN

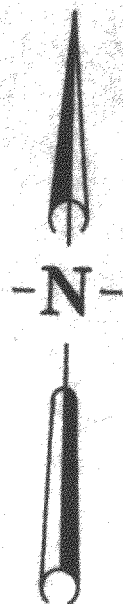

Scale 1"=40'

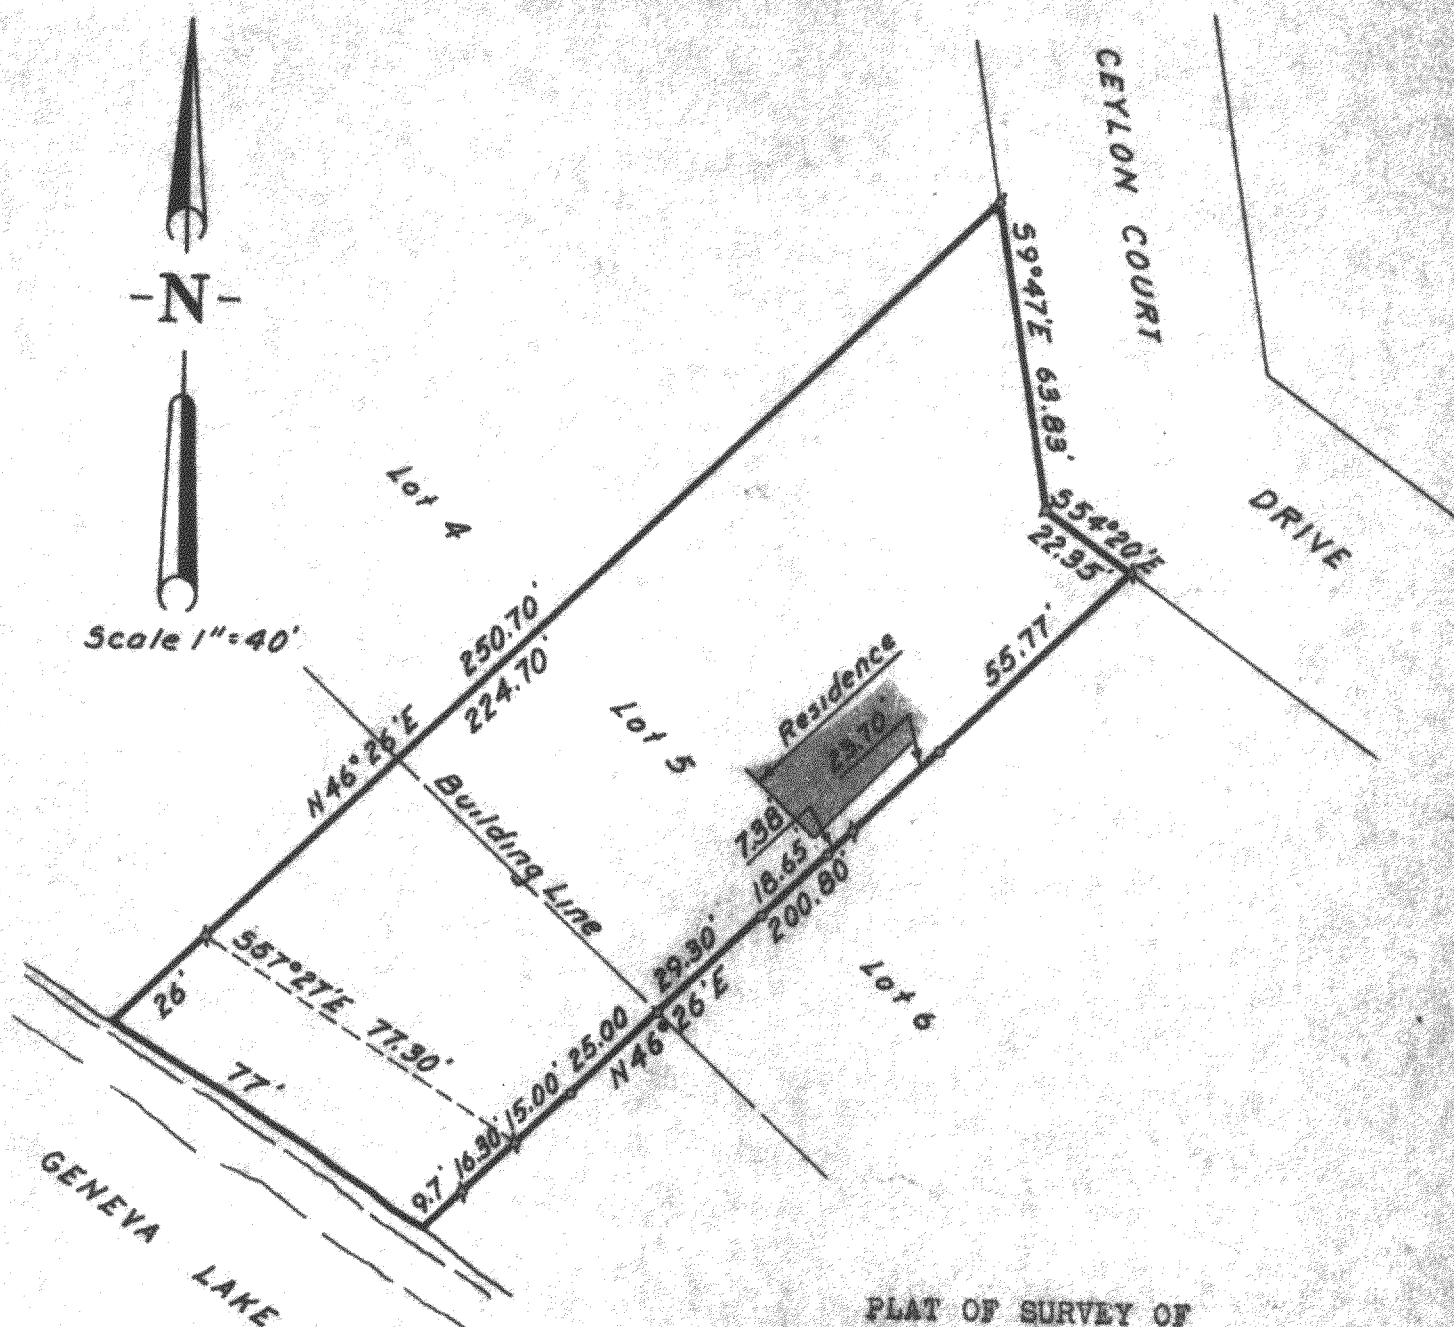

PLAT OF SURVEY OF

Lot 5, Ceylon Court Estates, City
of Lake Geneva, Walworth County,
Wisconsin.

Harold H. Kolb

Harold H. Kolb, Wis. Surveyor, S-187
DATE: October 24, 1963

• - Iron Pipe Found
o - Iron Pipe Placed

ZCE-5

7-156