




BOUNDARY & TOPOGRAPHIC SURVEY

UNIT 1 LONGWOOD CONDOMINIUM

LOCATED IN THE SE 1/4 OF SECTION 36,
TOWN 2 NORTH, RANGE 17 EAST, CITY OF
LAKE GENEVA, WALWORTH COUNTY, WISCONSIN

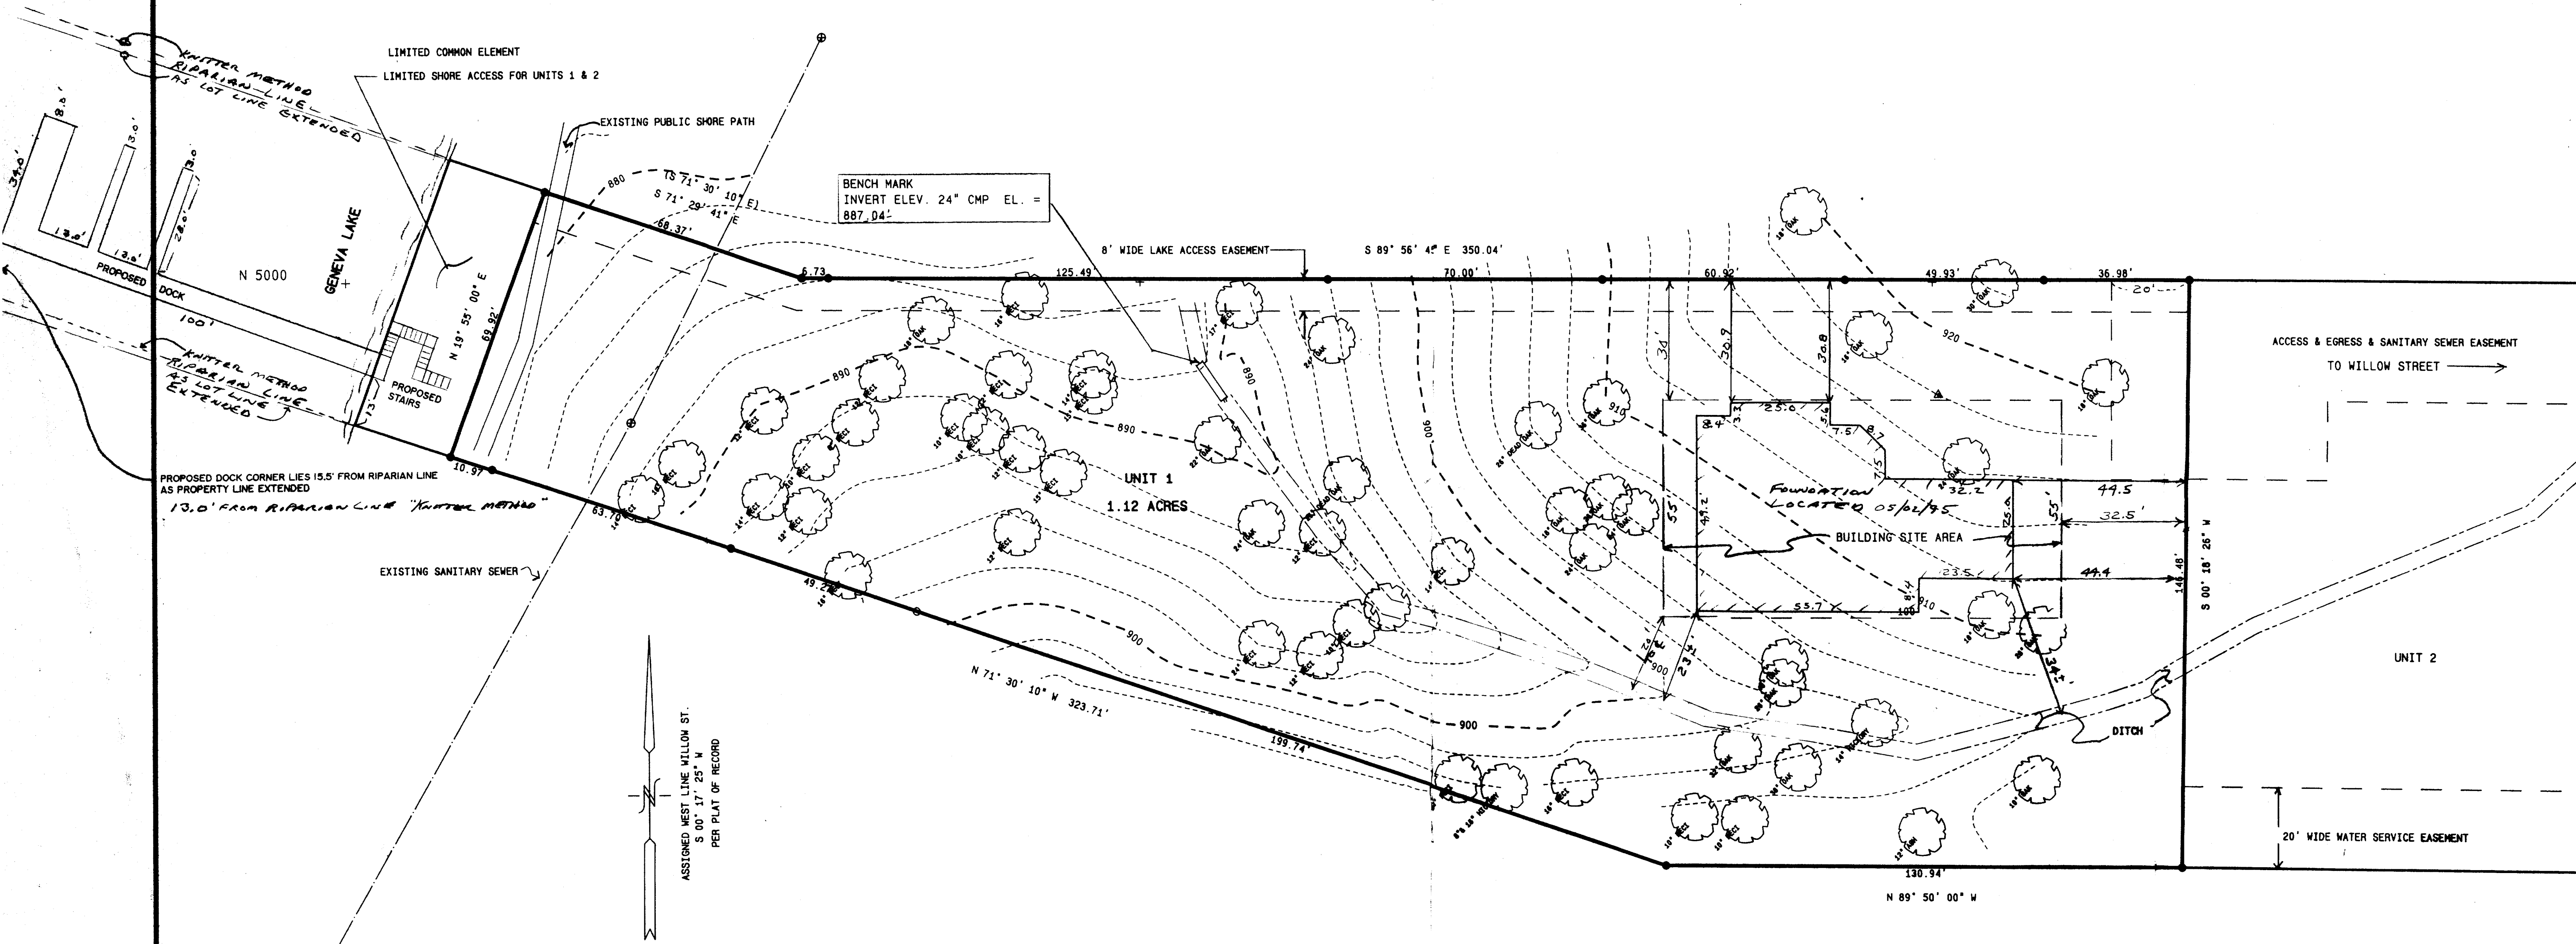

BENCH MARK
INVERT ELEV. 24" CMP EL. =
887.04'

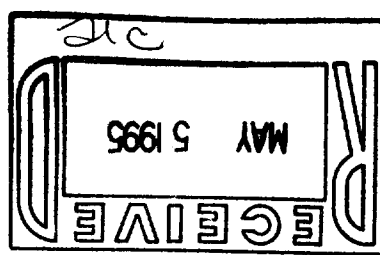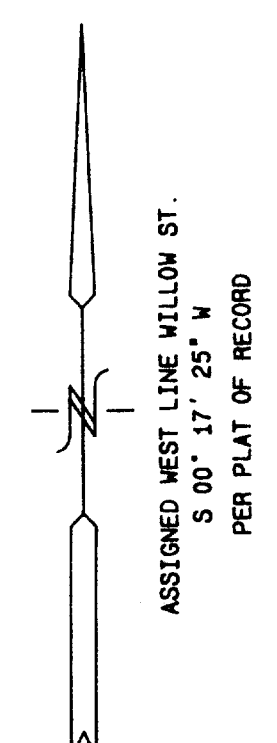

- LEGEND
- = FOUND IRON REBAR STAKE
 - = FOUND IRON PIPE STAKE
 - ⊗ = SANITARY SEWER MANHOLE
 - △ = WATER CURB STOP BOX
 - (---) = RECORDED AS

MAP SCALE IN FEET ORIGINAL 1" = 20'



NOTE: COPIES OF THIS MAP TO WHICH THE FOLLOWING CERTIFICATE WILL APPLY ARE BLUE LINE PRINTS SHOWING SURVEYOR'S ORIGINAL SEAL AND SIGNATURE IN BLACK INK. COPIES BY ANY OTHER MEANS MAY HAVE ALTERATIONS WHICH DO NOT REPRESENT THE SURVEYOR'S WORK PRODUCT.

I HEREBY CERTIFY THAT THE ABOVE DESCRIBED PROPERTY HAS BEEN SURVEYED UNDER MY DIRECTION AND THAT THE ABOVE MAP IS A TRUE REPRESENTATION THEREOF AND SHOWS THE SIZE AND LOCATION OF THE PROPERTY AND ITS EXTERIOR BOUNDARIES. THIS SURVEY IS MADE FOR THE USE OF THE PRESENT OWNERS OF THE PROPERTY, AND ALSO THOSE WHO PURCHASE, MORTGAGE, OR GUARANTEE THE TITLE THERETO WITHIN ONE YEAR FROM THE DATE HEREOF.

DATED: 02/01/95
 REVISED 2/17/95 TO CORRECT LOCATION OF BUILDING SITE AREA
 REVISED 04/12/95 TO SHOW LOCATION OF PROPOSED DOCK & STAIRS
 REVISED 05/03/95 TO SHOW SIZE AND LOCATION OF FOUNDATION



WORK ORDERED BY: RON MCCORMACK
 FOR LEHIS DRAPER
 PO BOX 498
 FONTANA, WISCONSIN

FARRIS, HANSEN & ASSOCIATES, INC.
 Engineering, Architecture, Surveying
 7 Ridgeway Court, P.O. Box 437
 ELKHORN, WISCONSIN 53121
 Office: (414) 723-2096
 Fax: (414) 723-5866

REVISIONS

PROJECT NO.	3952
DATE	01/31/95
SHEET NO.	1 OF 1