


COOK ST.

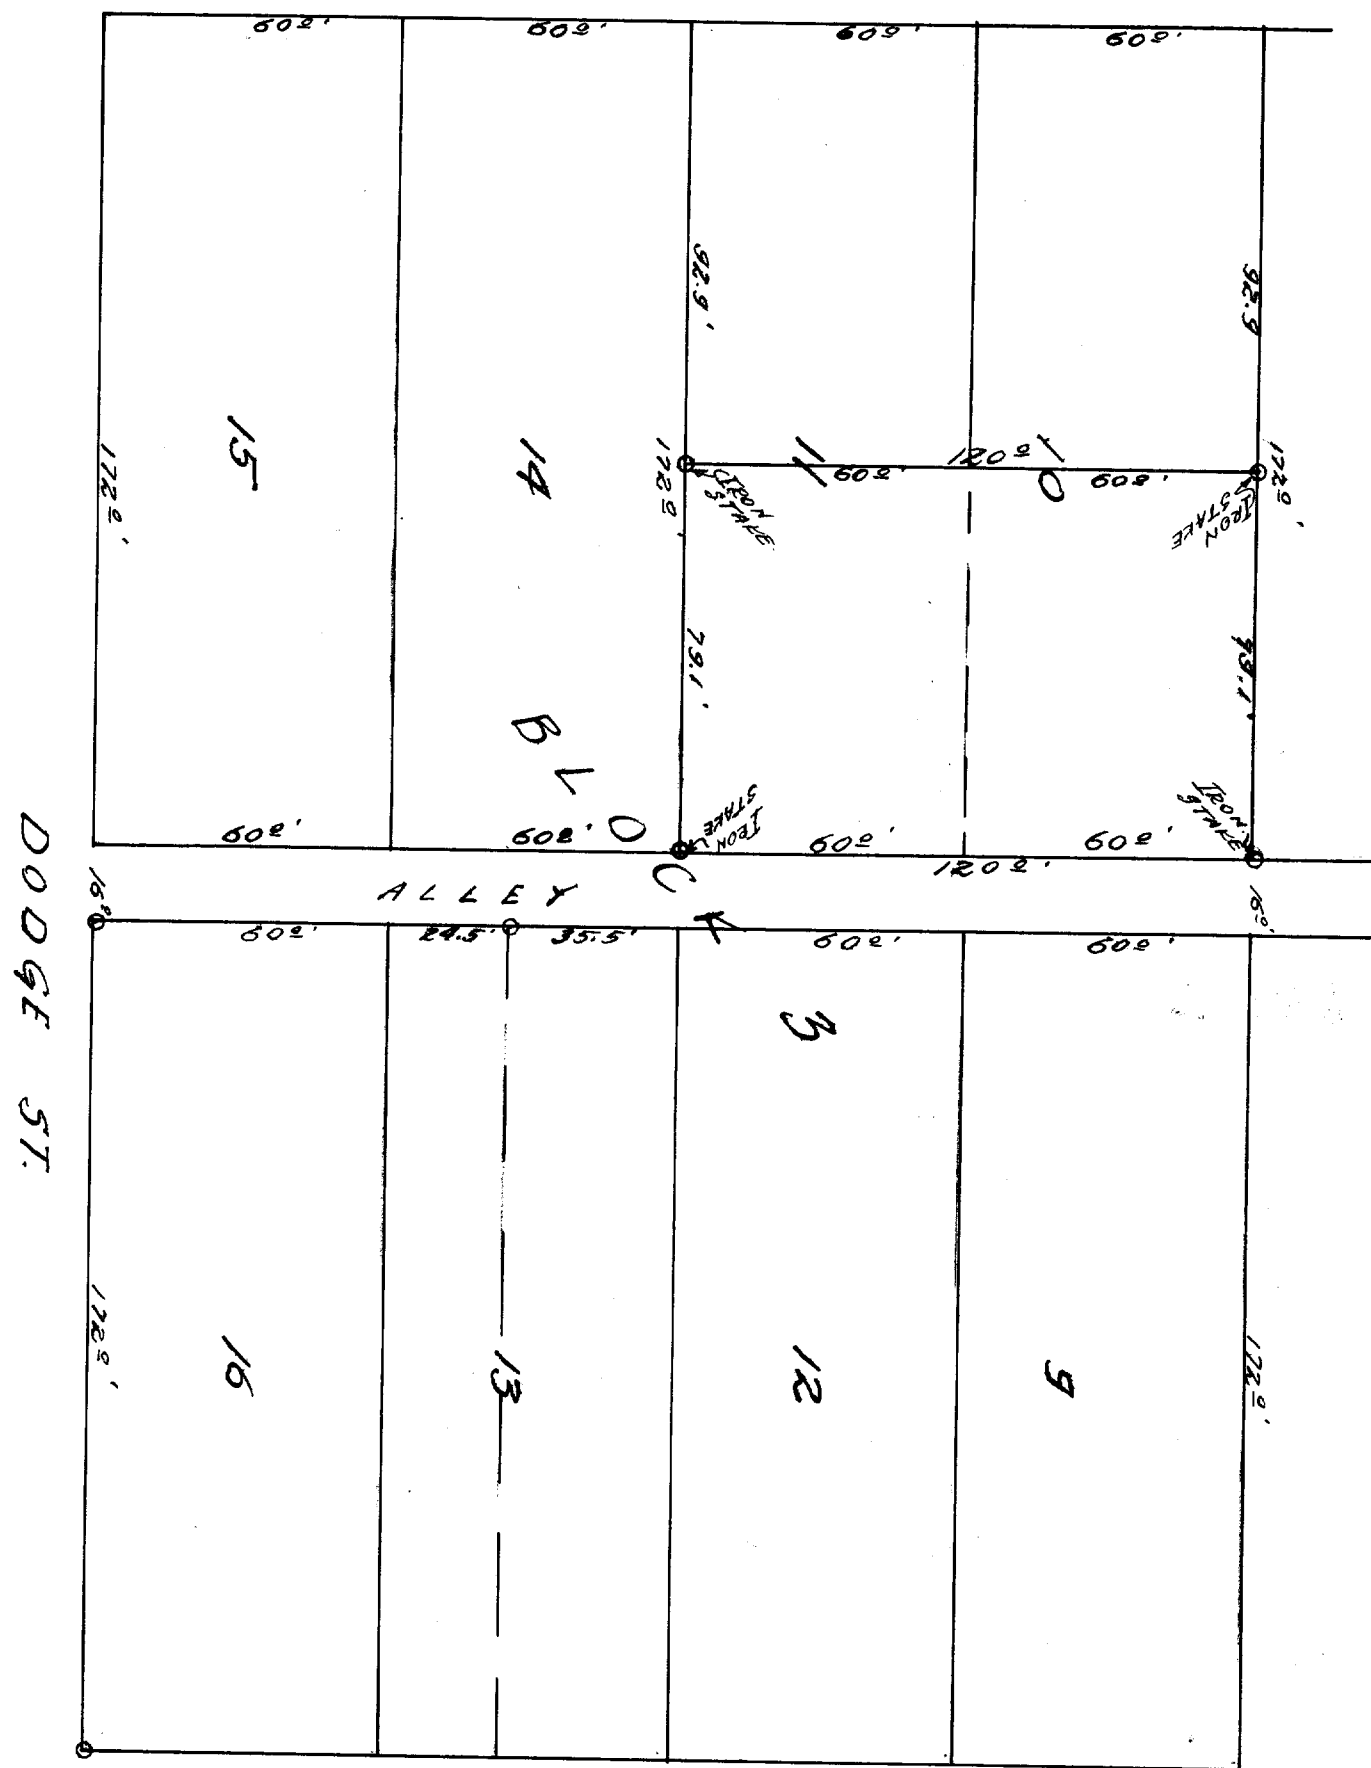

DESCRIPTION:

The east 79.1 feet of Lots 10 and 11, Block 3 Original Plat of Geneva Village, now City of Lake Geneva Walworth County, Wisconsin.

CERTIFICATE:

I, hereby certify that I have on this the 11th day of August 1951, surveyed the above described property, according to the official record on file in the office of the Recorder of Deeds in and for Walworth County, Wisconsin, and find that the measurements and bearings of the boundary lines of said property as taken at the site on this day, substantially agree with those in said official plat and that no encroachments exist.

SIGNED AND SEALED ON THIS THE 13TH DAY OF AUGUST 1951.

Joseph M. Biagi, Professional Engineer
Milwaukee Wisconsin.