


50-1878
100
100
100

WISCONSIN ST.

ST.

WARREN

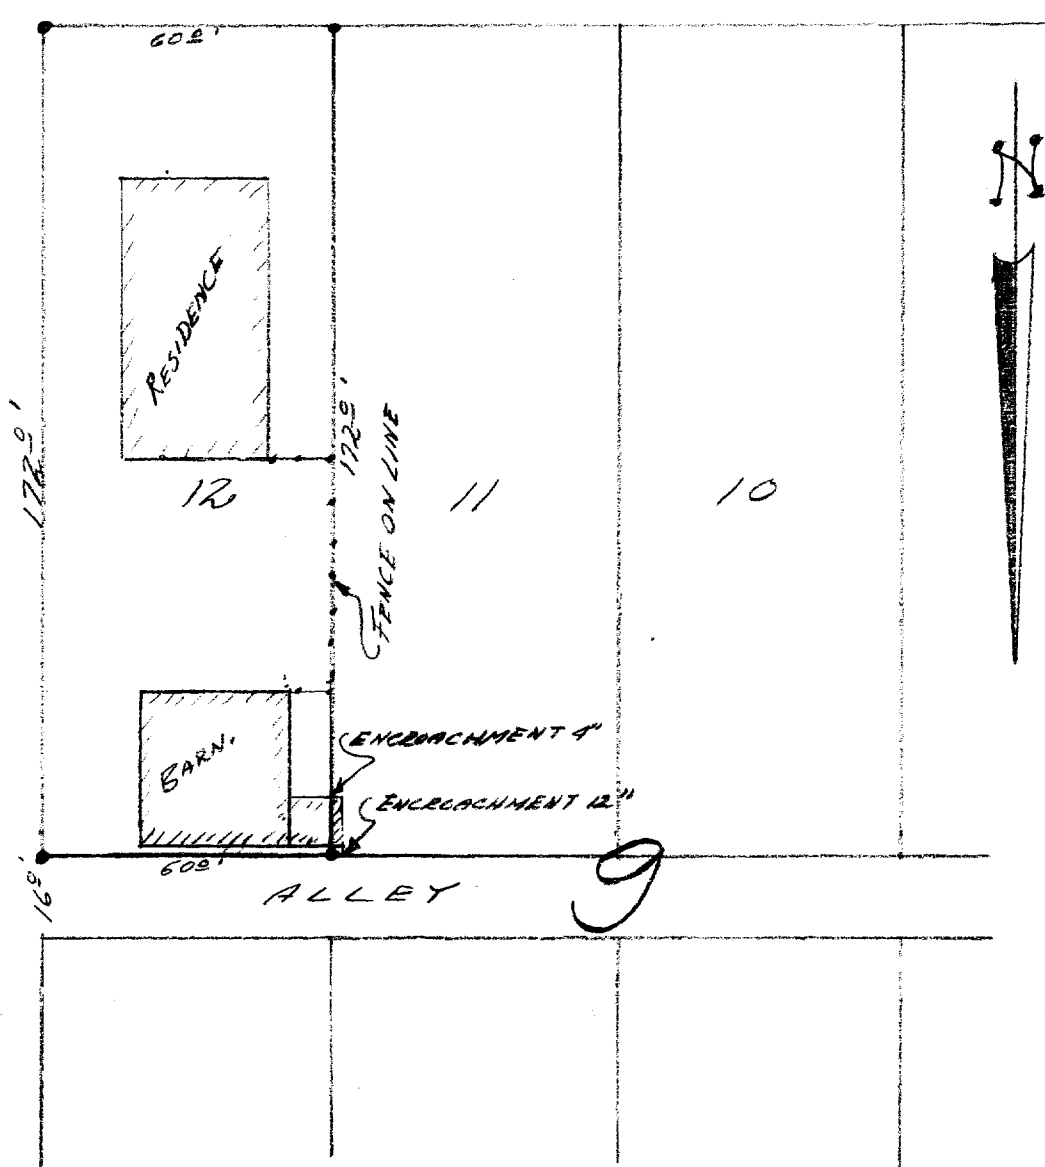

DESCRIPTION:

Lot 12 Block 9 Original Plat of the Village(now city) of Lake Geneva Walworth County, Wisconsin.

CERTIFICATE:

I, hereby certify that I have on this the 6th day of April 1950, surveyed the above described property according to the official records on file in the office of the Recorder of Deeds in and for Walworth County, and find that the measurements and bearings of the boundary lines of said property as taken at the site on this day, substantially agree with those in said official record and two encroachments exist on to lot 11 in said block, in the form of a shed, as shown on the plat shown above.
SIGNED AND SEALED ON THIS THE 8TH DAY OF APRIL 1950.

Joseph M. Biagi
Joseph M. Biagi. Professional Eng.
Elkhorn Wisconsin.