


ABELL
SURVEYING & MAPPING
DELAVAN, WISCONSIN 53115
414-728-6737


LAURIE STREET

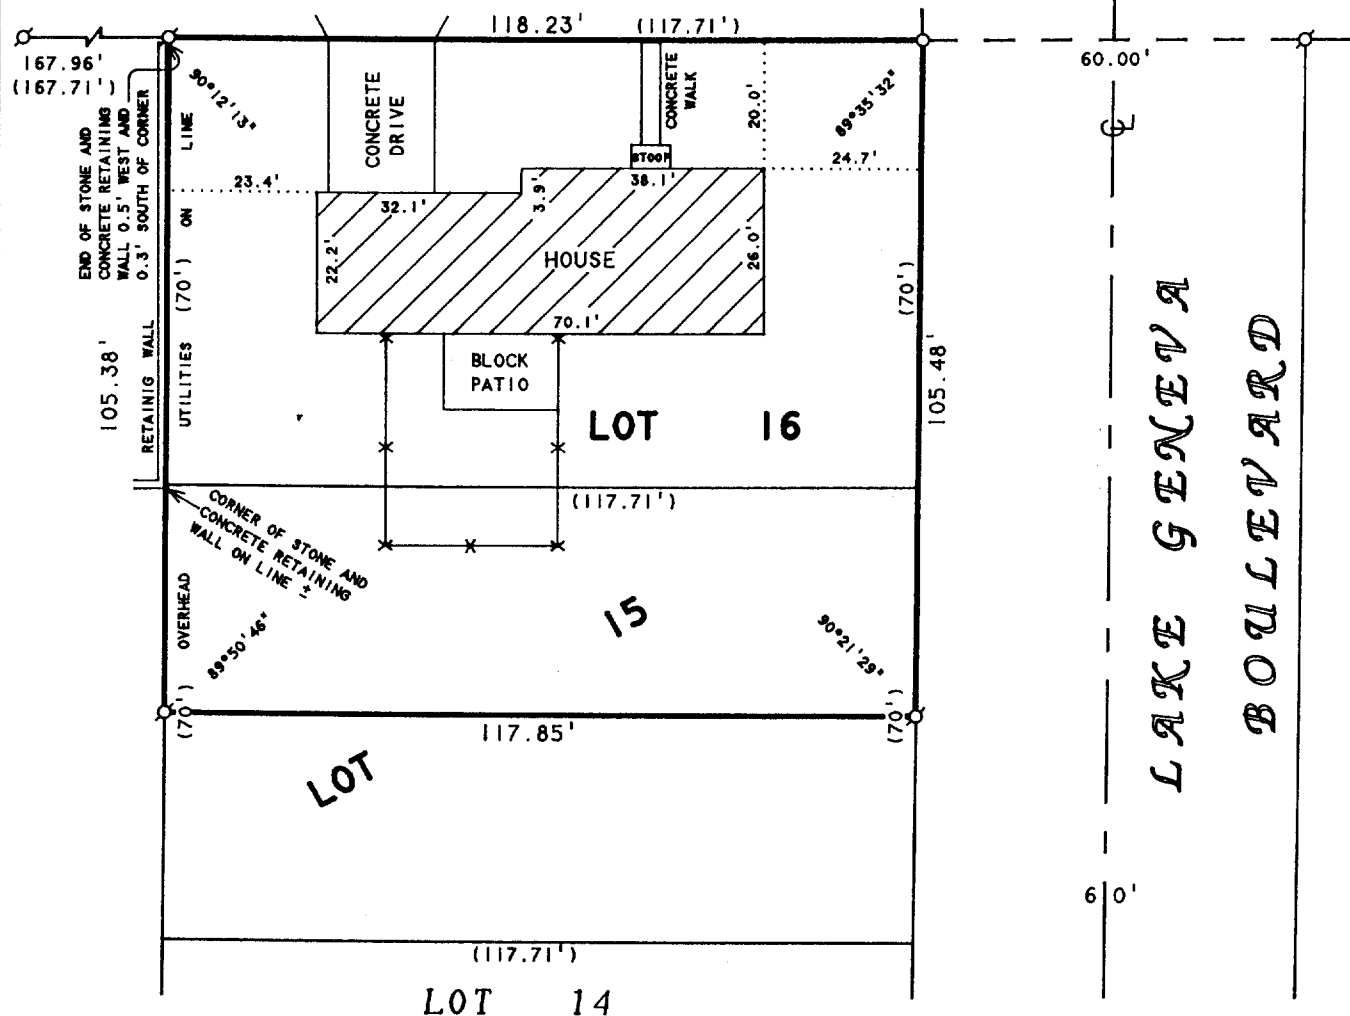

ORDERED BY: RE/MAX GENEVA REALTY, LTD.
101 BROAD STREET
LAKE GENEVA, WI 53147

PLAT OF SURVEY OF

LOT 16, AND THE NORTH 1/2 OF LOT 15,
H.E. WELLS ADDITION TO THE CITY OF
LAKE GENEVA, WALWORTH COUNTY, WISCONSIN

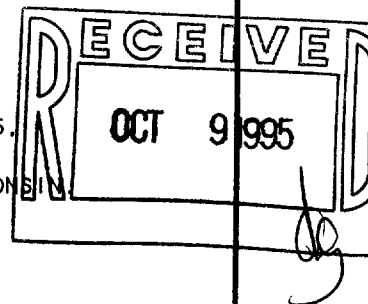

N



SCALE 1"=30'

LEGEND

- Ø - IRON PIPE FOUND
- - IRON BAR SET
- * - WOOD FENCE
- () - RECORDED AS

I HEREBY CERTIFY THAT I HAVE SURVEYED THE ABOVE DESCRIBED PROPERTY AND THAT THE ABOVE MAP IS A TRUE REPRESENTATION THEREOF AND SHOWS THE SIZE AND LOCATION OF THE PROPERTY, ITS EXTERIOR BOUNDARIES, THE LOCATION OF ALL VISIBLE STRUCTURES AND DIMENSIONS OF ALL PRINCIPAL BUILDINGS THEREON, BOUNDARY FENCES, APPARENT EASEMENTS, ROADWAYS AND VISIBLE ENCROACHMENTS, IF ANY, TO THE BEST OF MY KNOWLEDGE AND BELIEF.

THIS SURVEY IS MADE FOR THE USE OF THE PRESENT OWNERS OF THE PROPERTY, AND ALSO THOSE WHO PURCHASE, MORTGAGE, OR GUARANTEE THE TITLE THERETO WITHIN ONE (1) YEAR FROM DATE HEREON.

David F. Abell

DAVID F. ABELL
WISCONSIN REGISTERED LAND SURVEYOR, S-1596

September 19, 1995

DATE: September 19, 1995
JOB NUMBER - 95165
NOTE: THIS IS NOT A CERTIFIED COPY UNLESS SEALED.

ZWE-16

007-1605