
BROAD

5 T.

100 K

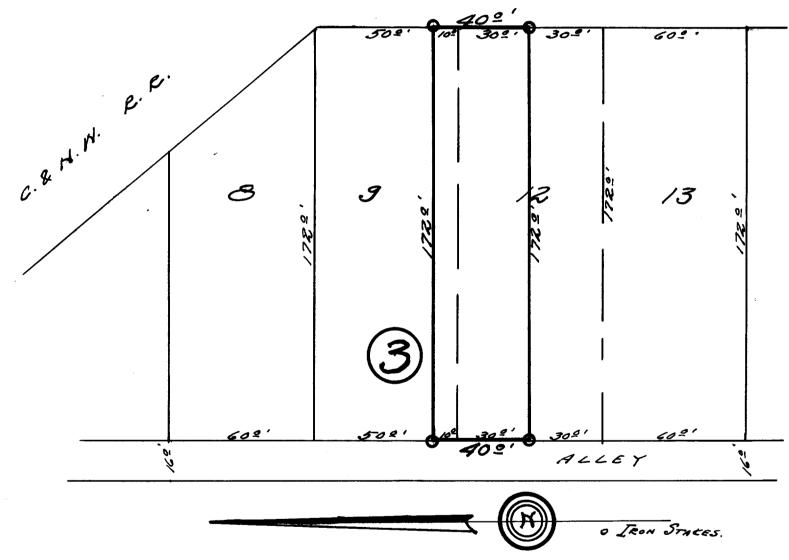

DESCRIPTION:

The north one half of Lot 12 and the south ten feet of Lot 9 Block & of the Original Plat of the City of Lake Geneva Walworth County, Wisconsin.

## CERTIFICATE:

I, hereby certify that I have on this the 5th day of April 1952, surveyed the above described property according to the official records on file in the office of the Recorder of Deeds in and for Walworth County, Wisconsin, and find that the measurements and bearings of the boundary lines of said property as taken at the site on this day, substantially agree with those in said official plat and that no encroachments exist.

SIGNED AND SEALED ON THIS THE 6TH DAY OF APRIL 1952.

GD-3

Joseph M Biagi. Professional Angineer 7-1618