
FARRIS, HANSEN, & ASSOCIATES, INC.

ENGINEERING, ARCHITECTURE, SURVEYING
7 RIDGWAY COURT - P.O. BOX 437, ELKHORN, WISCONSIN, 53121
PHONE: (414) 723-2098 FAX: (414) 723-5886

PLAT OF SURVEY UNIT 37 OF SOMERSET CONDOMINIUM BEING PART OF GREENRIDGE DOWNS

- WORK ORDERED BY -PAUL & KAREN ALBERTI C/O THE RAULAND AGENCY WALWORTH, W. 53184

LOCATED IN THE NW 1/4 OF SECTION 1, TOWN 1 NORTH, RANGE 17 EAST, CITY OF LAKE GENEVA, WALWORTH COUNTY, WISCONSIN

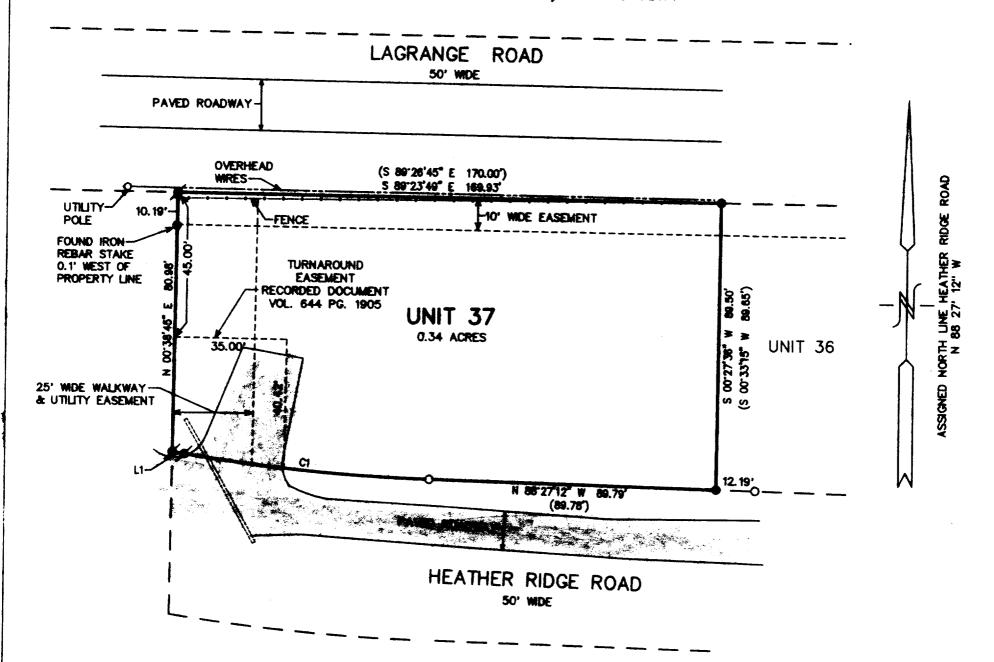

LINE BEARING DISTANCE

L1 N 80"41"38" W 3.81"

CURVE RADIUS CHD. BEARING CHD. DIST. ARC
C1 568.56 N 84"34"25" W 76.94" 77.00"

LEGEND

O = FOUND IRON PIPE STAKE

• = FOUND IRON REBAR STAKE

= SET IRON REBAR STAKE

(XXX) = RECORDED AS




NOTE: COPIES OF THIS MAP TO WHICH THE FOLLOWING CERTIFICATE WILL APPLY ARE BLUE LINE PRINTS SHOWING SURVEYOR'S ORIGINAL SEAL AND SIGNATURE IN BLACK INK. COPIES BY ANY OTHER MEANS MAY HAVE ALTERATIONS WHICH DO NOT REPRESENT THE SURVEYOR'S WORK PRODUCT.

I HEREBY CERTIFY THAT THE ABOVE DESCRIBED PROPERTY HAS BEEN SURVEYED UNDER MY DIRECTION AND THAT THE ABOVE MAP IS A TRUE REPRESENTATION THEREOF AND SHOWS THE SIZE AND LOCATION OF THE PROPERTY AND ITS EXTERIOR BOUNDARIES. THIS SURVEY IS MADE FOR THE USE OF THE PRESENT OWNERS OF THE PROPERTY, AND ALSO THOSE WHO PURCHASE, MORTGAGE, OR GUARANTEE THE TITLE THERETO WITHIN ONE YEAR FROM THE DATE HEREOF.

DATED: 6-14-98

Ofthe A Toron
PETER S. GORDON R.L.S. 2101

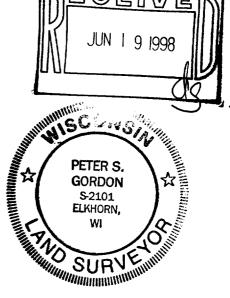

PROJECT 3786.98 DATE: 06/12/1998 SHEET 1 OF 1

