


54-19
3-1-50

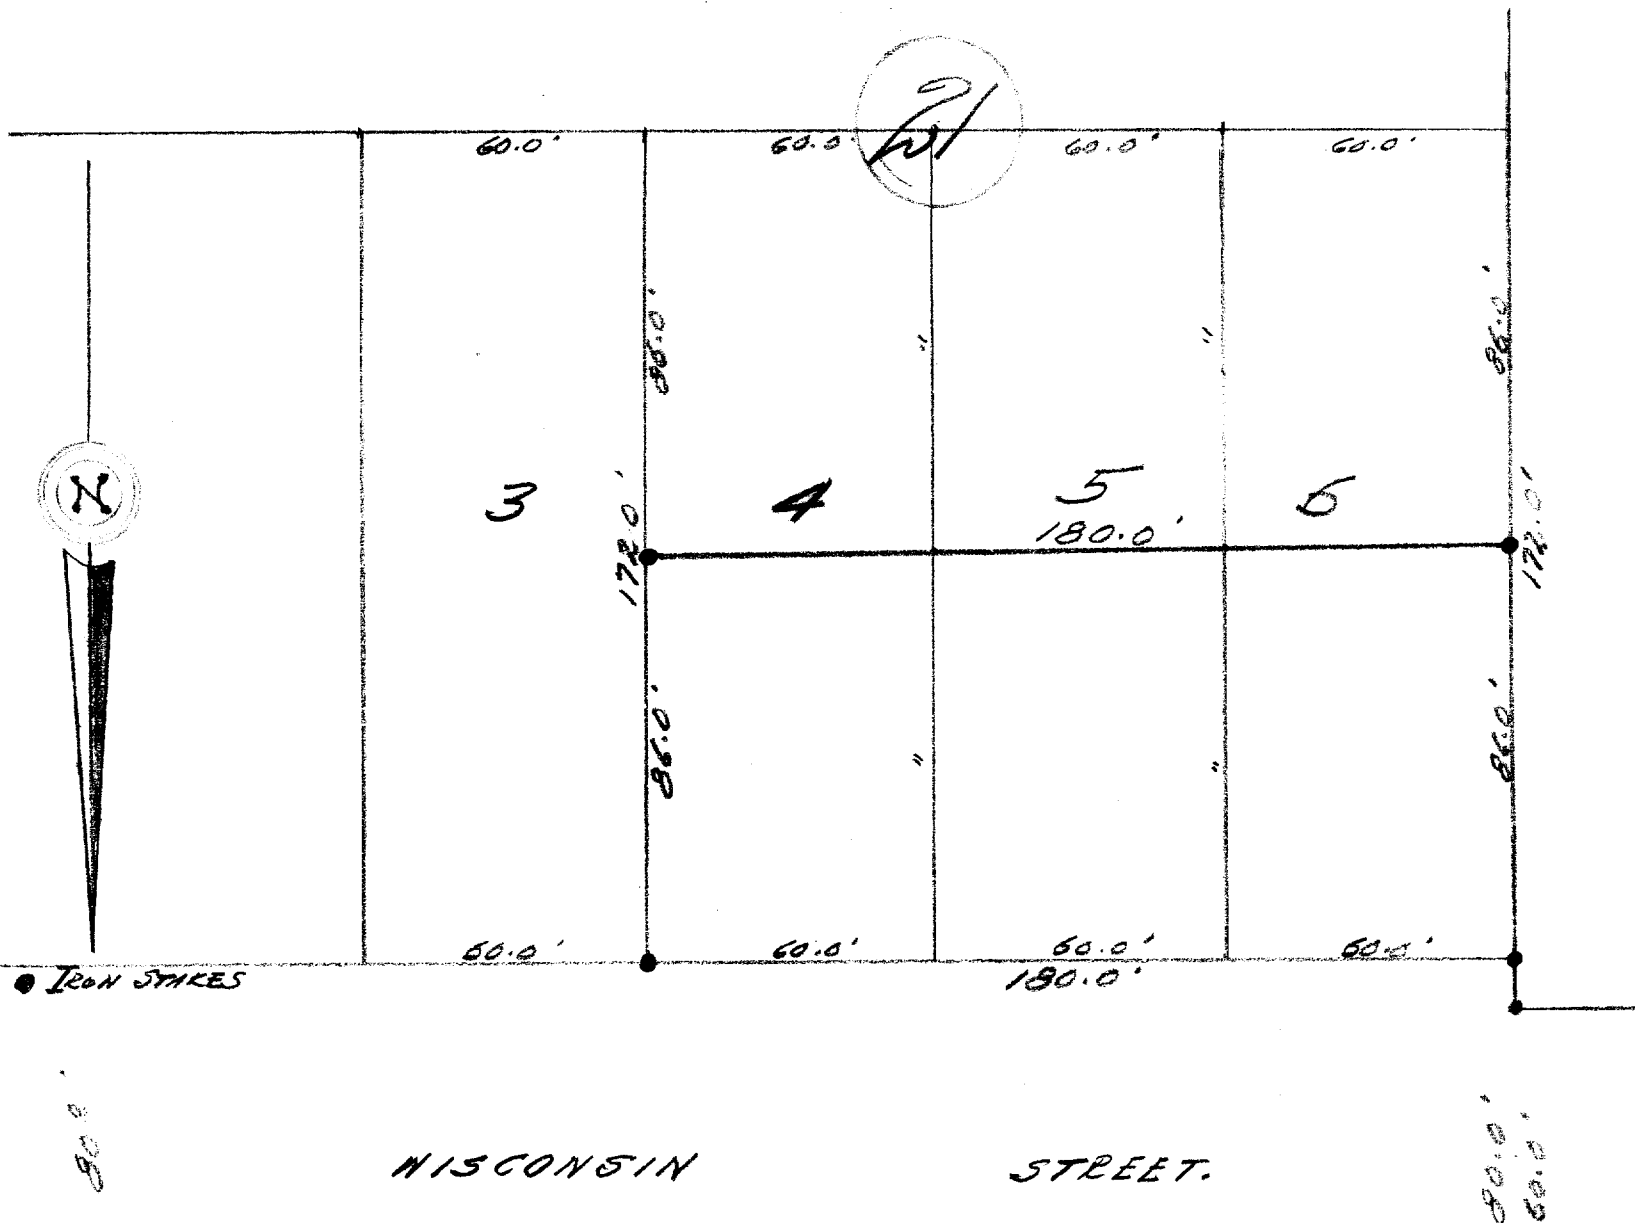

DESCRIPTION: The North one half of Lots 4, 5, and 6, Block 21 of the Original Plat of the Village (now city) of Lake Geneva, Walworth County, Wisconsin.

CERTIFICATE: I, hereby certify that I, have on this the 5th day of January 1954, surveyed the above described property.

SIGNED AND SEALED ON THIS THE 6TH DAY OF JANUARY 1954.

Joseph M. Biagi
Joseph M. Biagi, Professional Engineer.
Elkhorn Wisconsin.

OP-198 + OP-199

7-176B