

A decorative vertical line with a flag and a banner. The line is thin and black, with a small black dot near the top. A flag is attached to the line, and a banner is attached to the line. The banner is rectangular and contains the text "THE NEW YORK PUBLIC LIBRARY". The flag is triangular and contains the text "ASTEN LENOX TILDEN FOUNDATION". The line is decorated with a small black dot near the top and a small black dot near the bottom.



BROAD

₹

50.00

87.00
70.

40.00'

Block 13

7		8
---	--	---

120.00

EAST

39

四

1

21

ότι

2

39

120.00 WEST

44

37.00' SOUTH

WISCONSIN

57


DESCRIPTION:

The South 87.00 feet of Lots 7 and 8 of Block 13 of the Original Plat of the City of Lake Geneva, Walworth County, Wisconsin.

CERTIFICATE:

I, James F. Biagi, Surveyor do hereby certify that I have surveyed the property hereon described, and that the location of all the improvements are as shown on the drawing.

January 10th 1962.

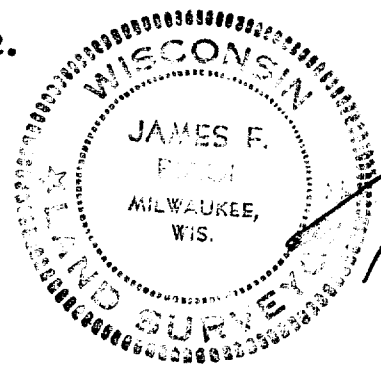

~~James F. Biagi. (Surveyor 272)~~
~~Kilbourn, Wisconsin~~