
PLAT OF SURVEY

LOCATION: 1735 Eagle Drive, Lake Geneva, Wisconsin

Lot 10 in <code>EDGEWOOD HILLS</code>, a subdivision located in the LEGAL DESCRIPTION: Southwest 1/4 and the Southeast 1/4 of the Northeast 1/4 and the Northeast 1/4 and the Northwest 1/4 of the Southeast 1/4 of Section 26, Town 2 North, Range 17 East, Town of Geneva and City of Lake Geneva, Walworth County, Wisconsin.

October 7, 1998

Survey No. 90226

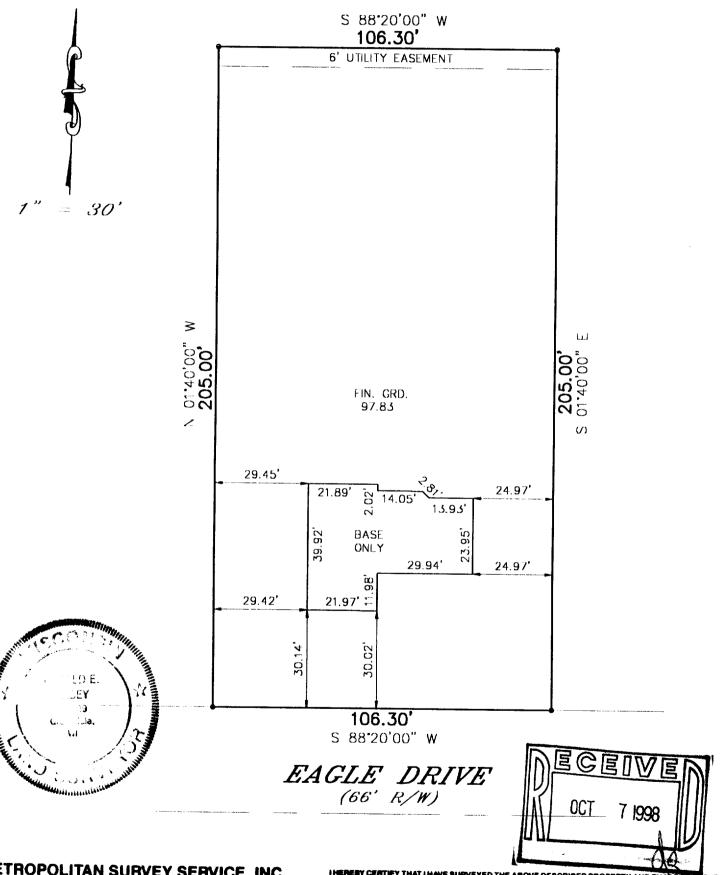

METROPOLITAN SURVEY SERVICE, INC.

REGISTERED LAND SURVEYORS 9415 W. FOREST HOME AVE., SUITE 202, HALES CORNERS, WI 53130 PH. 529-5380 FAX 529-9787

I HEREBY CERTIFY THAT I HAVE SURVEYED THE ABOVE DESCRIBED PROPERTY AND THAT THE ABOVE MAP IS A TRUE REPRESENTATION THEREOF AND SHOWS THE SIZE AND LOCATION OF THE PROPERTY. ITS EXTERIOR BOUNDARIES, THE LOCATION OF ALL VISIBLE STRUCTURES AND DIMENSIONS OF ALL PRINCIPAL BUILDINGS THEREON, BOUNDARY FENCES, APPARENT EASEMENTS AND ROADWAYS AND MINISTER EASEMENTS AND ROADWAYS AND VISIBLE ENCROACHMENTS, IF ANY.

THIS SURVEY IS MADE FOR THE EXCLUSIVE USE OF THE PRESENT OWNERS OF THE PROPERTY, AND ALSO THOSE WHO PURCHASE, MORTGAGE, OR GUARANTEE THE TITLE THERETO WITHIN ONE (1) YEAR FROM DATE HEREOF.

Gerald E. Casey latered Land Surveyor \$-1329