
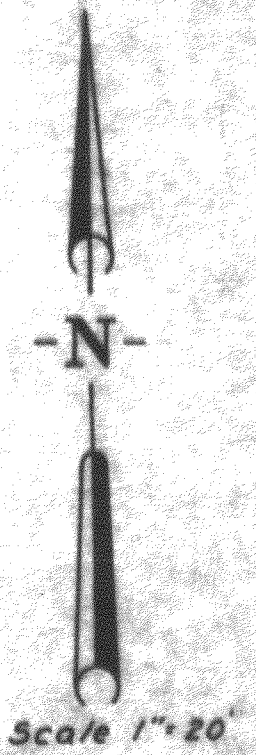


HAROLD H. KOLB
REGISTERED PROFESSIONAL LAND SURVEYOR
LAKE GENEVA, WISCONSIN

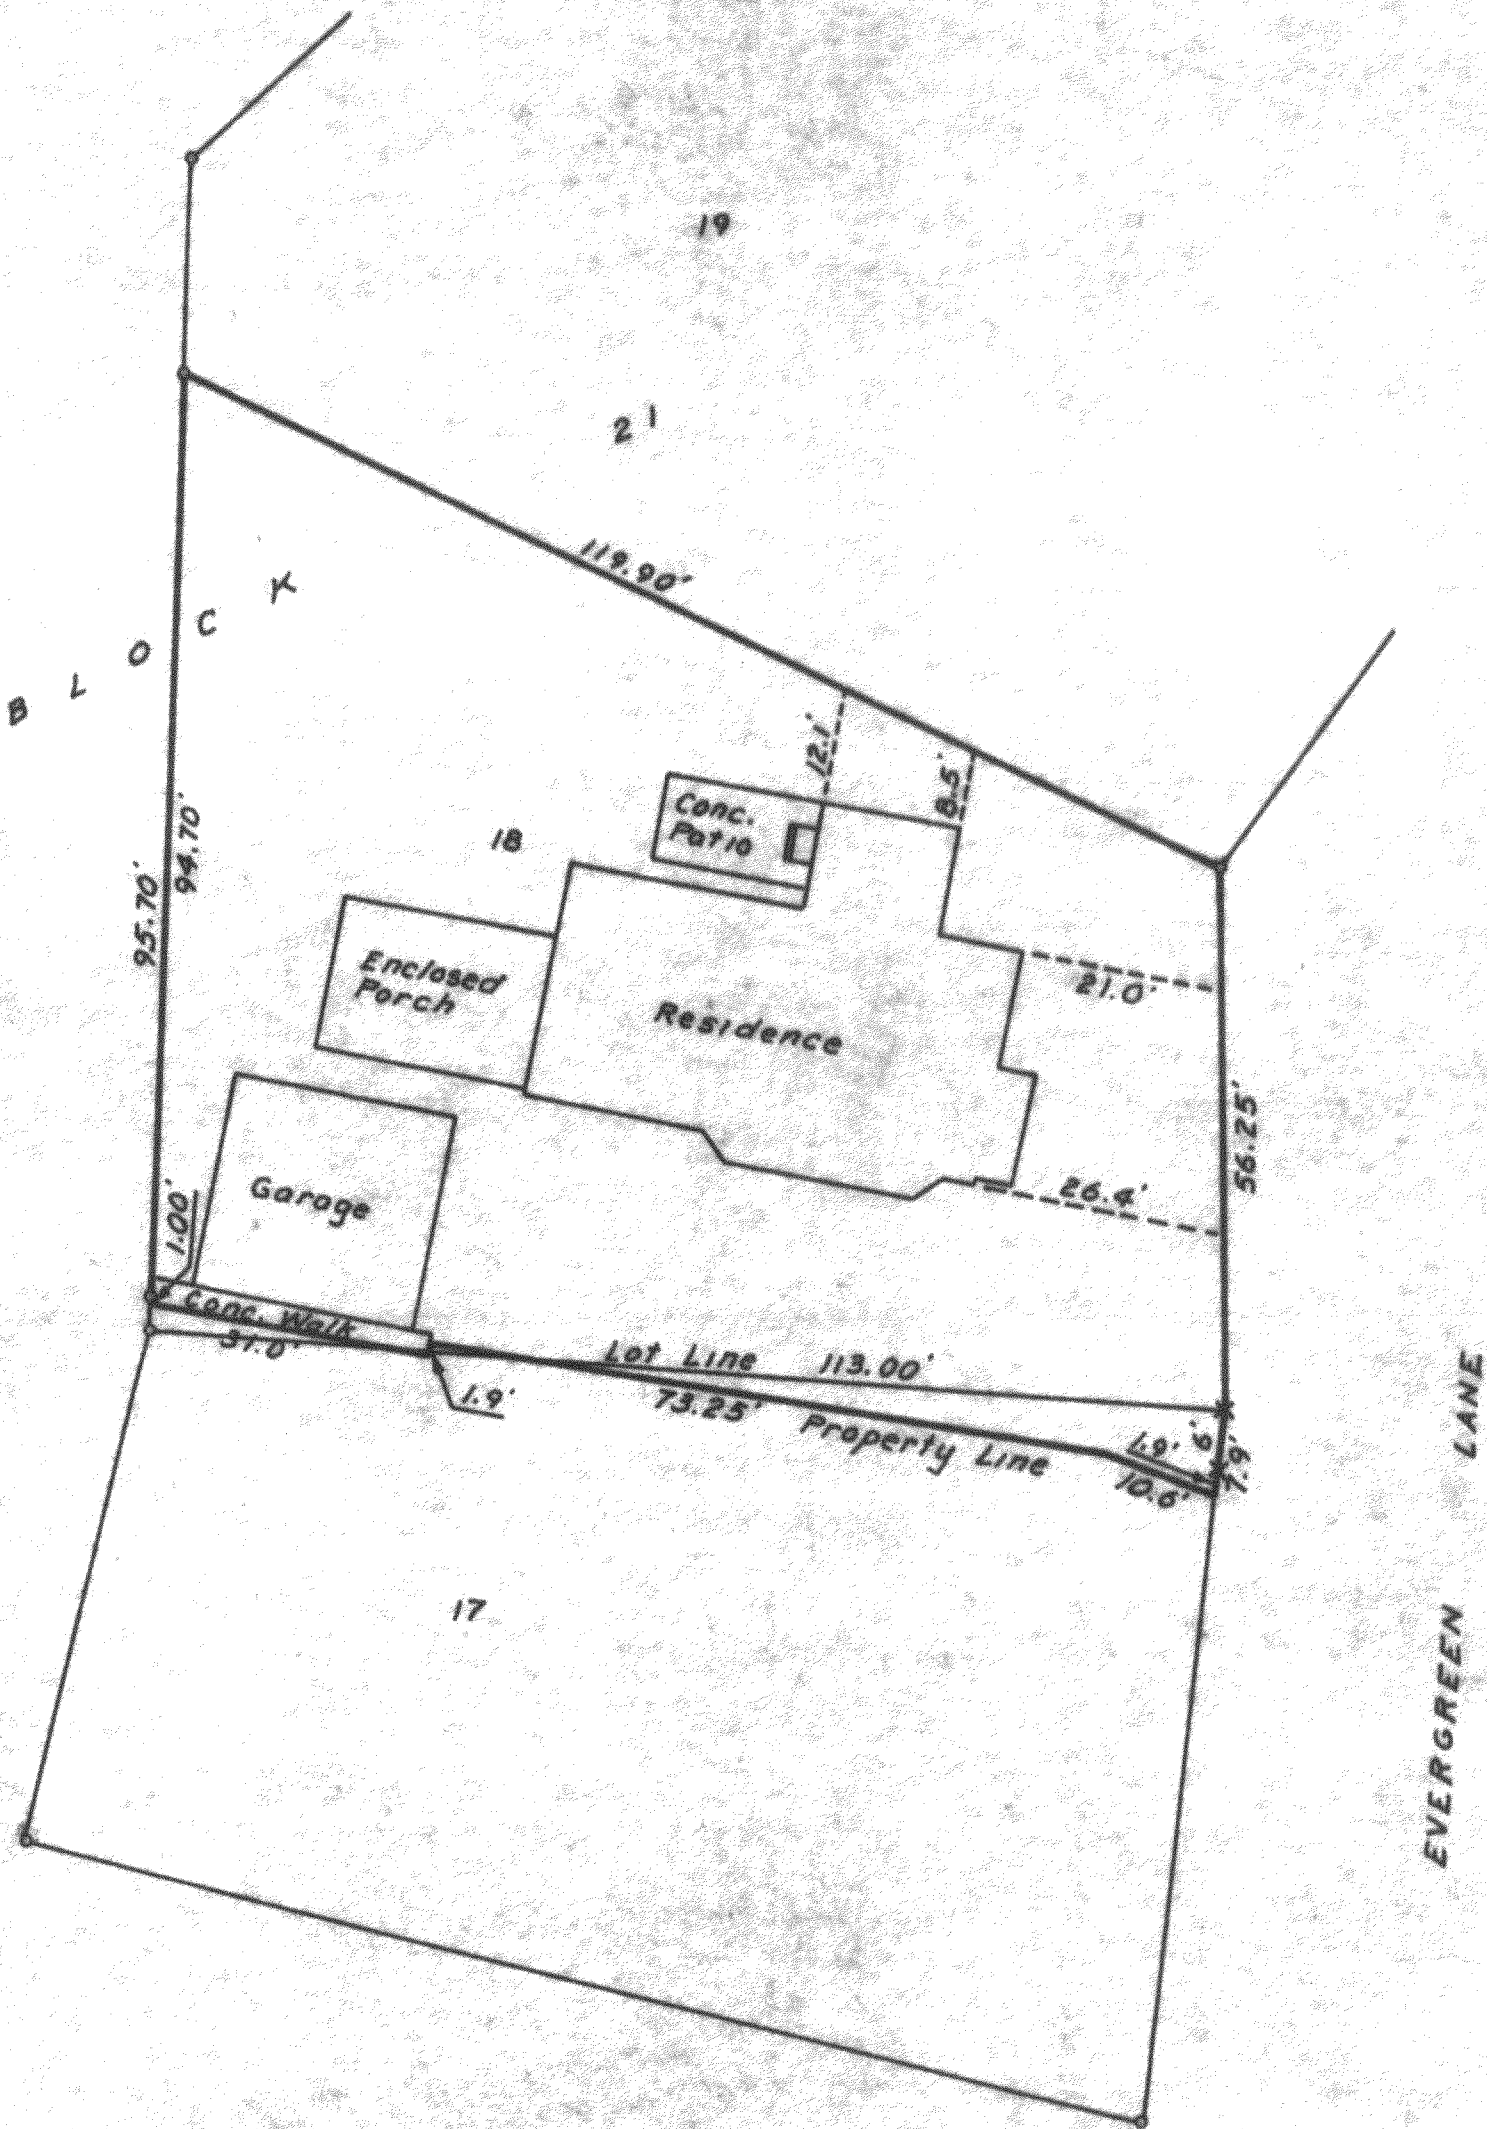

PLAT OF SURVEY OF

Lot 18 and part of Lot 17, Block 21, Lake Geneva Manor, A subdivision located in the East 1/2 of Section 35, T 2 N, R 17 E, City of Lake Geneva, Walworth County, Wisconsin.

Harold H. Kolb

Harold H. Kolb, Wisconsin Surveyor, S-187

DATE: August 6, 1964

GP - 187

24M-65

7-181