

**PATHFINDER SURVEYING**  
FORMERLY KOLB LAND CONSULTING  
929 WILLIAMS STREET LAKE GENEVA, WI. 53147  
(414) 248-3697

DATE: 2-24-1999

C.L. HASKINS STREET (66') WIDE

DESCRIPTION: THE NORTH 112.00 FEET OF LOT 1, BLOCK 18  
GENEVA LAKE CRAWFORD MANUFACTURING ADDITION  
TO THE VILLAGE NOW CITY OF LAKE GENEVA,  
WALWORTH COUNTY, WISCONSIN.




Q FOUND IRON PIPE  
(XXX) RECORDED AS  
~~X~~ FENCE

THE ABOVE MAP IS A TRUE REPRESENTATION THEREOF AND SHOWS THE SIZE AND LOCATION OF ALL THE PROPERTY, EXTERIOR BOUNDARIES, THE LOCATION OF ALL VISIBLE BOUNDARY FENCES , APPARENT EASEMENTS , ROADWAYS AND VISIBLE ENCROACHMENTS , IF ANY

THIS SURVEY IS MADE FOR THE USE OF THE PRESENT OWNERS OF THE PROPERTY , AND ALSO THOSE WHO PURCHASE , MORTGAGE OR GURANTEE TITLE THERETO WITHIN ONE (1) YEAR FROM DATE HERETO.

John P Krott  
JOHN P. KROTT , R.L.S. 2258

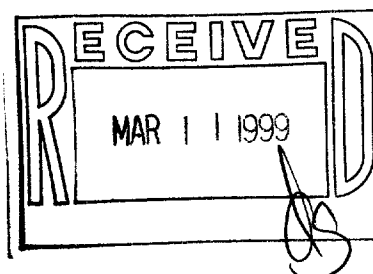

NOTE: THIS IS NOT A CERTIFIED COPY  
UNLESS SEAL IS IN RED.

JOB NUMBER 990034 ZG 600090

ZGC-90

007-1812