
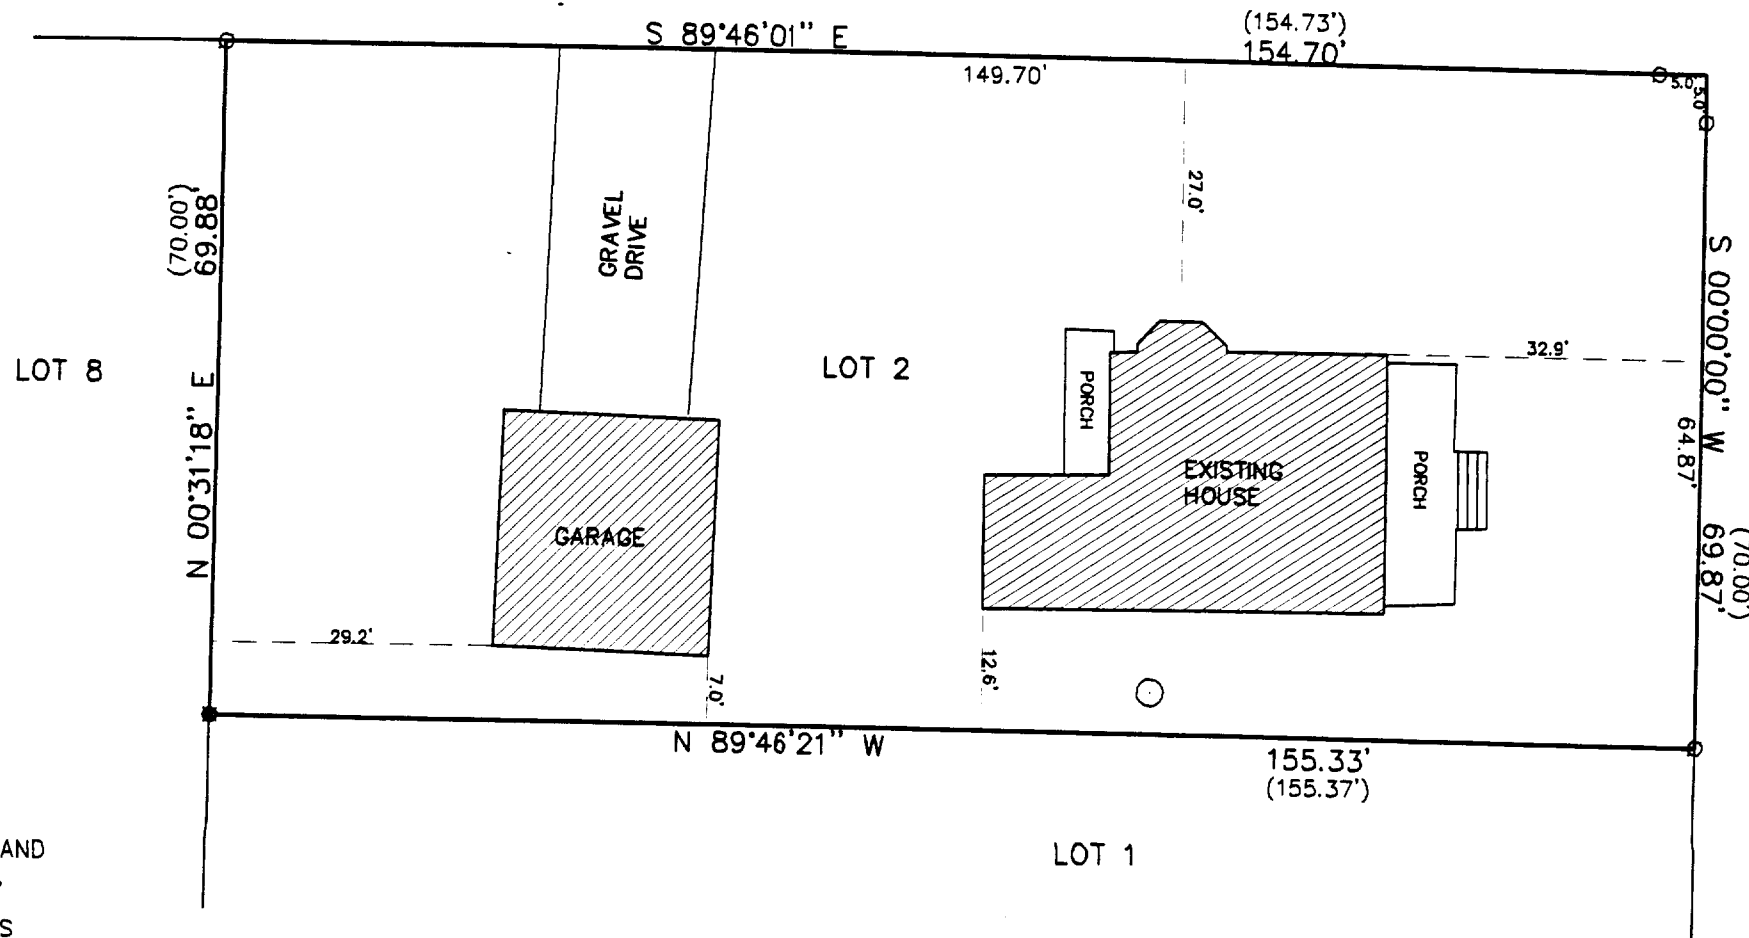


PLAT OF SURVEY

ORDERED BY: COLDWELL BANKER
838 W MAIN ST.
LAKE GENEVA, WI. 53147

DESCRIPTION: LOT 2 KOHN'S SECOND SUBDIVISON BEING
PART OF THE SW 1/4 OF SECTION 25,
T2N, R17E, IN THE CITY OF LAKE GENEVA,
WALWORTH COUNTY WISCONSIN.

C.L. ROGER COURT (50') WIDE

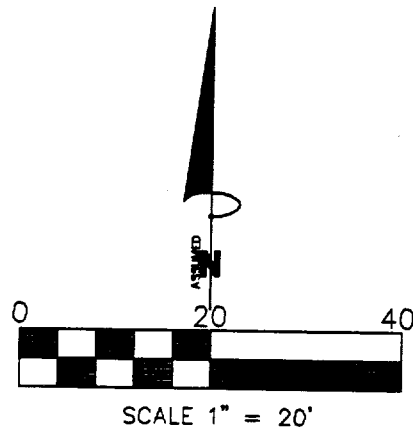


THE ABOVE MAP IS A TRUE REPRESENTATION THEREOF AND SHOWS THE SIZE AND LOCATION OF ALL THE PROPERTY, EXTERIOR BOUNDARIES, THE LOCATION OF ALL VISIBLE BOUNDARY FENCES, APPARENT EASEMENTS, ROADWAYS AND VISIBLE ENCROACHMENTS, IF ANY

THIS SURVEY IS MADE FOR THE USE OF THE PRESENT OWNERS OF THE PROPERTY, AND ALSO THOSE WHO PURCHASE, MORTGAGE OR GURANTEE TITLE THERETO WITHIN ONE (1) YEAR FROM DATE HERETO.

PATHFINDER SURVEYING
FORMERLY KOLB LAND CONSULTING
929 WILLIAMS STREET LAKE GENEVA, WI. 53147
(414) 248-3697

- LEGEND
- FOUND IRON PIPE
 - FOUND IRON PIN
 - MANHOLE
 - (XXX) RECORDED AS

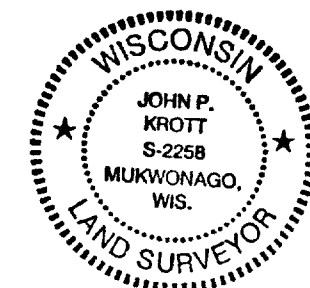

John P. Krott
JOHN P. KROTT, R.L.S. 2258
DATE: 3/11/1999

NOTE: THIS IS NOT A CERTIFIED COPY UNLESS SEAL IS IN RED.
JOB NUMBER 99046 ZK200002

057-1832

ZK2-2