
ABELL SURVEYING & MAPPING

1140 SEQUOIA STREET • DELAVAN, WISCONSIN 53115 414-728-6737

WHEELER

STREET

60 FEET WIDE

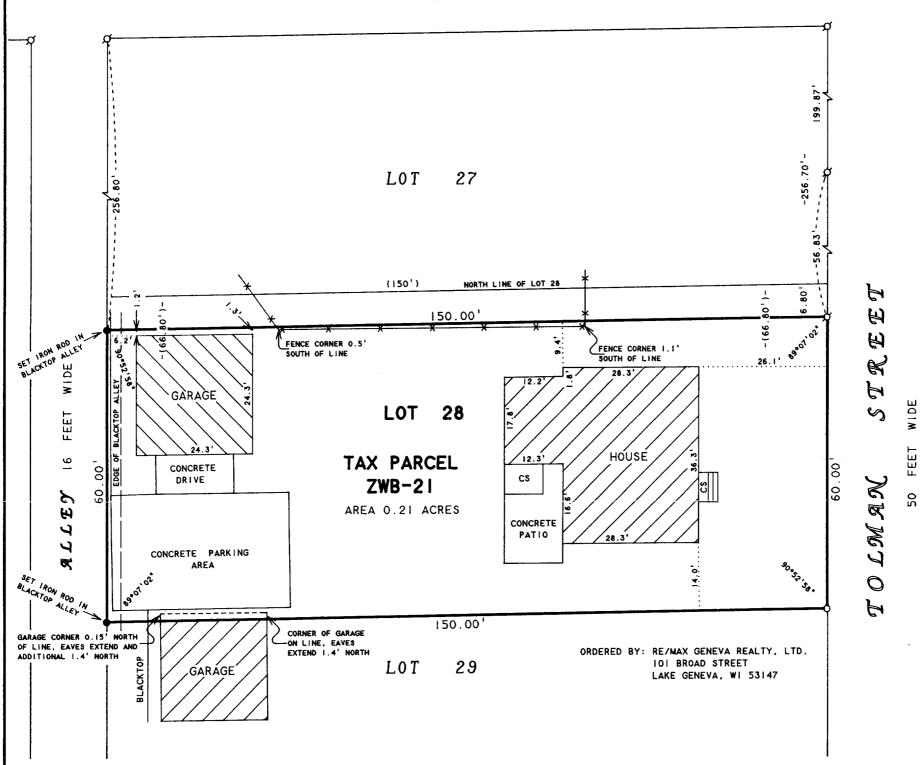

PLAT OF SURVEY OF

THE SOUTH 60 FEET OF LOT 28 OF WATSON'S BOULEVARD ADDITION, LOCATED IN THE CITY OF LAKE GENEVA, WALWORTH COUNTY, WISCONSIN.



SCALE | " = 20'

LEGEND

Ø -IRON PIPE FOUND
O -I" DIA. IRON PIPE SET
■ -3/4" DIA. IRON ROD SET
CS -CONCRETE STOOP

I HEREBY CERTIFY THAT I HAVE SURVEYED THE ABOVE DESCRIBED PROPERTY AND THAT THE ABOVE MAP IS A TRUE REPRESENTATION THEREOF AND SHOWS THE SIZE AND LOCATION OF THE PROPERTY, ITS EXTERIOR BOUNDARIES, THE LOCATION OF ALL VISIBLE STRUCTURES AND DIMENSIONS OF ALL PRINCIPAL BUILDINGS THEREON, BOUNDARY FENCES, APPARENT EASEMENTS, ROADWAYS AND VISIBLE ENCROACHMENTS, IF ANY, TO THE BEST OF MY KNOWLEDGE AND BELIEF.

THIS SURVEY IS MADE FOR THE USE OF THE PRESENT OWNERS OF THE PROPERTY. AND ALSO THOSE WHO PURCHASE, MORTGAGE. OR GUARANTEE THE TITLE THERETO WITHIN ONE (!) YEAR FROM DATE HEREON.

David 7. All

DAVID F. ABELL WISCONSIN REGISTERED LAND SURVEYOR, S-1596

June 21, 1999

JOB NUMBER - 99099

DATE JOB NUMBER -