
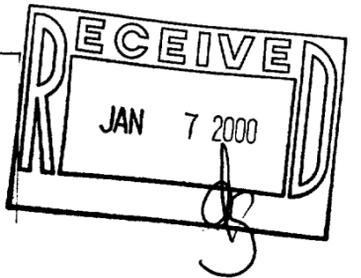


PLAT OF SURVEY

OF

the East 50 feet of Lot 11, Block 4 of WHEELER'S ADDITION, located in the City of Lake Geneva, Walworth County, Wisconsin.

LEGAL DESCRIPTION AS PROVIDED.

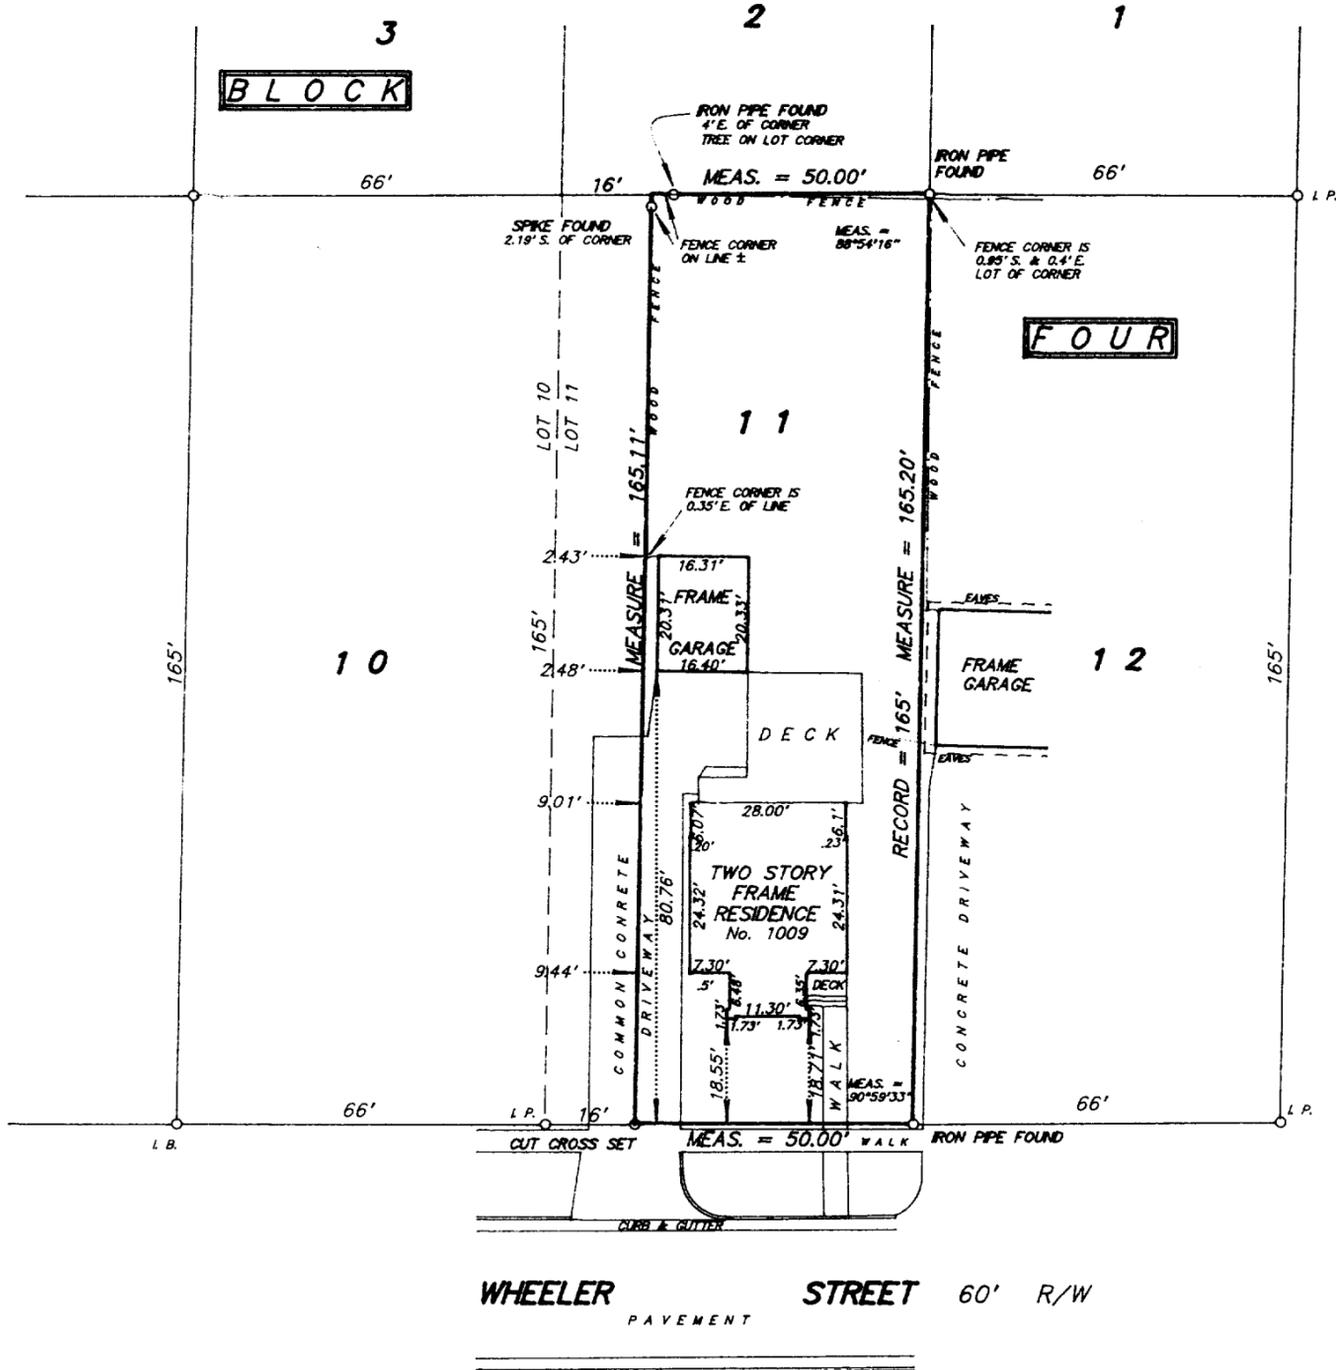

WATSON BOULEVARD SUBDIVISION



SCALE 1 inch = 30 feet

ORDERED BY D. Schiltz / Davison, Mulligan & Schiltz, LTD.

JOB NO. 99144

I hereby certify that I have surveyed the above described property and the above plat is a true representation thereof and shows the size and location of the property, its exterior boundaries, the location and dimensions of all visible structures thereon, boundary fences, apparent easements and roadways and visible encroachments, if any.

This survey is made for the exclusive use of the present owners of the property, and also those who purchase, mortgage, or guarantee the title thereto within one year from the date hereof.

Dated at Bassett, Wisconsin this _____ day of _____ 1999.

Mark A. Bolender
 Wisconsin Registered Land Surveyor S - 1784

ZW4-23
 107-1863