## **ABERNATHY** and **ASSOCIATES**


Kenneth B. Abernathy Jr.

Wisconsin Registered Land Surveyor 5-1594

Rt. 3, Box 273

Elkhorn, Wisconsin 53121

Phone: (414) 723-4260 (office) [414] 723-4813 (residence)

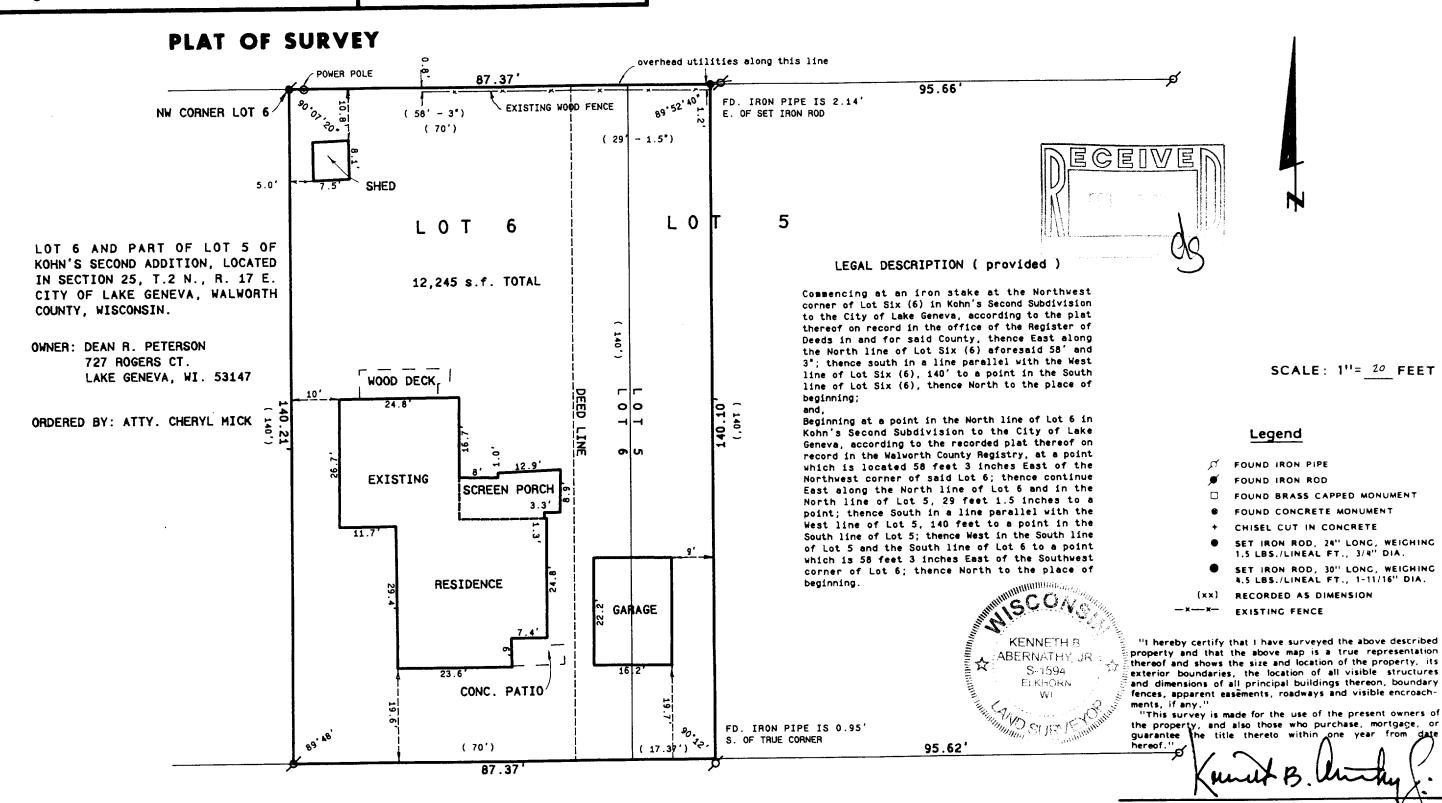

KENNETH B. ABERNATHY, JR. WISCONSIN REGISTERED LAND SURVEYOR,

S-1594

Date: JAN 24, 2000

\_ Job No..

SCALE: 1"= 20 FEET

Legend

FOUND IRON PIPE

FOUND IRON ROD

FOUND BRASS CAPPED MONUMENT

1.5 LBS./LINEAL FT., 3/4" DIA.

SET IRON ROD. 24" LONG, WEIGHING

SET IRON ROD, 30" LONG, WEIGHING 4.5 LBS./LINEAL FT., 1-11/16" DIA.

FOUND CONCRETE MONUMENT

CHISEL CUT IN CONCRETE

RECORDED AS DIMENSION

EXISTING FENCE