SURVE PLAT

PATHFINDER SURVEYING FORMERLY KOLB LAND CONSULTING 929 WILLIAMS ST. LAKE GENEVA, WI. (262) 248-3697

ORDERED BY: ORION PARTNERS

P.O. BOX 1030


LAKE GENEVA, WI. 53147


DATE: 3-24-2000

DESCRIPTION:

THE EAST 44.00 FEET OF LOTS 14 AND 15 OF BLOCK 3 OF GOODSELL'S SUBDIVISION OF BLOCK 3 OF THE PLAT OF THE VILLAGE OF GENEVA, NOW CITY OF LAKE GENEVA, WALWORTH COUNTY, WISCONSIN.

THE WEST 65.00 FEET OF THE EAST 109.00' OF LOTS 14 AND 15 OF BLOCK 3 OF GOODSELL'S SUBDIVISION OF BLOCK 3 OF THE VILLAGE, NOW CITY OF LAKE GENEVA, WALWORTH COUNTY, WISCONSIN.

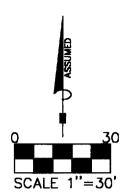

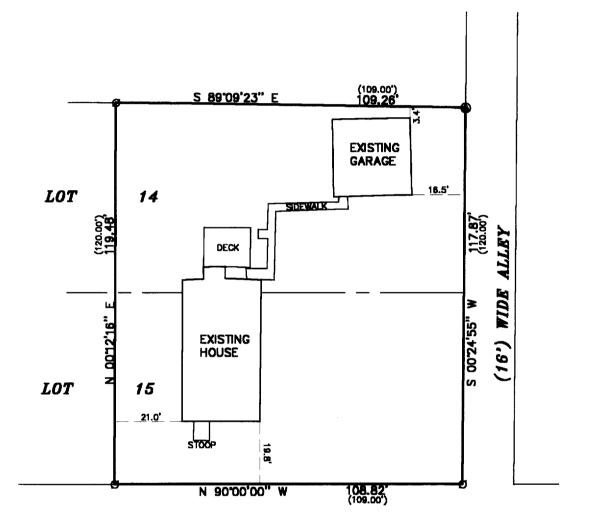

C.L. DODGE STREET

LEGEND


Ø FOUND IRON PIPE

SET P.K. NAIL

THE ABOVE MAP IS A TRUE REPRESENTATION THEREOF AND SHOWS THE SIZE AND LOCATION OF ALL THE PROPERTY, EXTERIOR BOUNDARIES, THE LOCATION OF ALL VISIBLE BOUNDARY FENCES, APPARENT EASEMENTS, ROADWAYS AND VISIBLE ENCROACHMENTS, IF ANY.

THIS SURVEY IS MADE FOR THE USE OF THE PRESENT OWNERS OF THE PROPERTY, AND ALSO THOSE WHO PURCHASE, MORTGAGE OR GURANTEE TITLE THERETO WITHIN ONE (1) YEAR FROM DATE HERETO.

(XXXX)

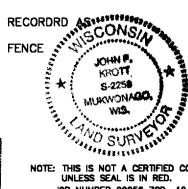

NOTE: THIS IS NOT A CERTIFIED COPY UNLESS SEAL IS IN RED. JOB NUMBER 00056 ZGD 12

JOHN P. KROTT, R.L.S. 2258

CE

ZGD-12

007-